

KANSAS

Rush County


FORM 51 5M PETROL

Section 35 Township 19 Range 16W

Well No. 2 Ed Peterson

Company Magnolia

5

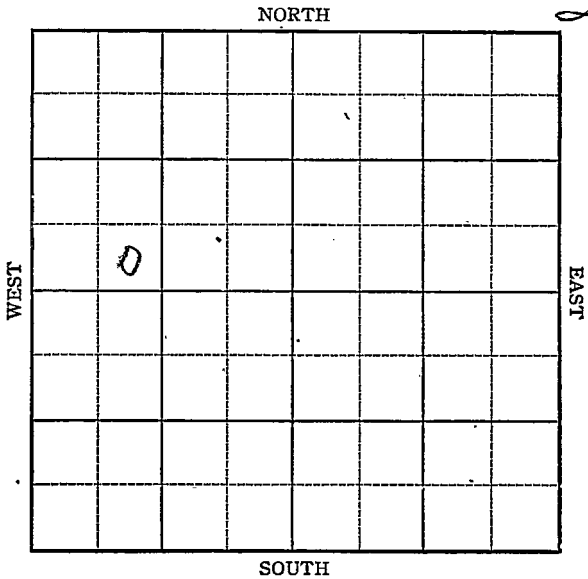

Sec. 35 Twp. 19 R. 16W

Well No. 2 Ed Peterson Farm

Magnolia Company


Ryan

 Ft. from N. Line

330 Ft. from S. Line

 Ft. from E. Line

990 Ft. from W. Line

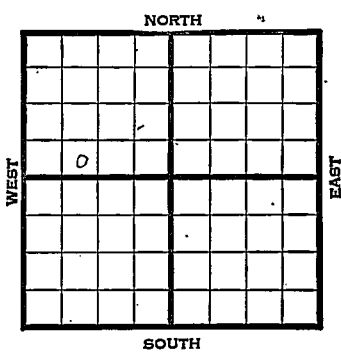

SE SW NW Elev. 1977

1945

REPORT

- 5/16 Location
- 5/24 RUR
- 5/31 8" @ 1010' WOC
- 6/8 Drlg. 3000
- 6/14 Lams 3376
Arb 3669
TD 3755
5" @ 3755- RUST
- 6/21 Arb 3661-3770 TD
5" @ 3770 RUST
- 6/28 Plug 3720-52shots 3770-20 SD
- 7/3 500 acid. 5 fluid per hr. 20% wtr.
- 7/11 PB 3696' WOC
- 7/19 108 shots. 3677-3708 1500 acid
Flow 1/3 fluid PH - 24 hrs.
- 7/26 PB 3718
32 shots 3710-3718
1000 acid.
Flow 2 fluid per hr. 24 hrs. 15% wtr.
- 8/1 Arb. 3669
5" @ 3755'
Perf. arb.
425 acid
Flow 44 Pot.
T.D. 3755'
Gravity 39

COMPLETED

Kansas Pool Name Ryan

Map No. 81 Sec. 35 Twp. 19 R. 16W

Well No. 2 Ed Peterson

Magnolia Company

FIRST REPORT

Contractor

SE SW NW

SECTION PLAT

 Ft. from N. Line

330 Ft. from S. Line

 Ft. from E. Line

990 Ft. from W. Line

	2		

Rush

Location X

Rig up

Drilling and Remarks:

RECORD

Cased in., ft.

Sand

Gas

Oil

Total Depth

PRODUCTION

1st 24 hrs. Nat.

1st 24 hrs. after shot

Gas Cu. Ft.

Dry Hole

Abandoned

Date

MAY 16 1945 19

S. J. LEWIS Scout

