


Section 35 Township 19 Range 12W

Well No. #3 Hammer "B"

Company W.L. Hartman

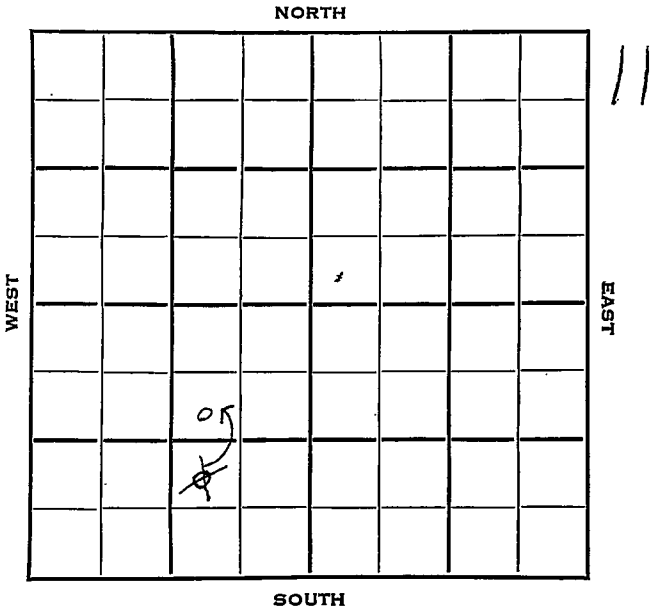

Sec. 35 Twp. 19 R. 12W

Well No. ~~#3~~ #1 Hammer #B* Farm

W. L. Hartman Company

Contractor

990 Ft. from N. Line


990 Ft. from S. Line

990 Ft. from E. Line

_____ Ft. from W. Line

~~NW SE SW~~

SW NE SW

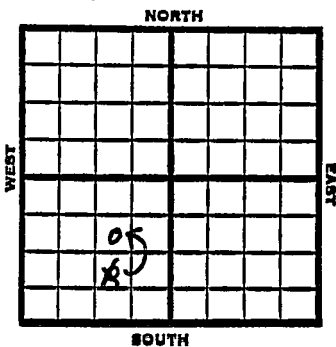

1953

Elev. -

REPORT

4/22

Location

4/30

"

5/7

"

5/21

"

5/28

N.R.

6/3

NR

6/24

SWD well TD 3454' Lans 3105
 Arb. 3347 OTD 3390
 DD 3454'
 Comp. for SWD well

ABANDONED

Map No. _____ Sec. 35 Twp. 19 R. 12WWell No. 1 Hammer "B"W. L. Hartman Company

CORRECTION

Contractor

~~NW SE~~
~~SW NE SW~~

SECTION PLAT

990 Ft. from N. Line

_____ Ft. from S. Line

990 Ft. from E. Line

_____ Ft. from W. Line

	X o		

Barton County

Location _____

Rig up _____

Drilling and Remarks:

Reported
#3 Hammer

RECORD

Cased _____ in., _____ ft.

Sand _____

Gas _____

Oil _____

Total Depth _____

PRODUCTION

1st 24 hrs. Nat. _____

1st 24 hrs. after shot _____

Gas _____ Cu. Ft.

Dry Hole _____

Abandoned _____

Date

APR 20 1953

19

J. G. McGEHEE

Scout

Map No. _____ Sec. 35 Twp. 19 R. 12W

Well No. 1 Hammer

W. L. Hartman Company

CORRECTION Contractor

SW NE SW

SECTION PLAT

990 Ft. from N. Line

_____ Ft. from S. Line

990 Ft. from E. Line

_____ Ft. from W. Line

	o		

Barton County

Location _____

Rig up _____

Drilling and Remarks:

Reported
#3 Hammer "B"
NW SE SW

RECORD

Cased _____ in., _____ ft.

Sand _____

Gas _____

Oil _____

Total Depth _____

PRODUCTION

1st 24 hrs. Nat. _____

1st 24 hrs. after shot _____

Gas _____ Cu. Ft.

Dry Hole _____

Abandoned _____

Date

JUN 24 1953 19

J. G. McGEHEE

Scout

OWWO

County Barton State KANSAS

Sec. 35 (Blk. Twp.) 19 (Sur. Rge.) 12W Map No.

Operator W. L. Hartman

Well No. 1 Farm Hammer

Elev. Location SW NE SW

990 Ft. From N Line SW
990 Ft. From E Line Quarter

1st. Report

Completion JUN 24 1953

Remarks OWWO

Spudding Date O.W.W.O.

Drig. Data SWD well TD 3454

Lans. 3105 Arb. 3347 OTD 3390

DD 3454 Comp. for SWD well

*Correct spot
from pg. 2
to pg. 2*