


Section 36 Township 19 Range 11-W

Well No. #7 Schmidt

Company Texas

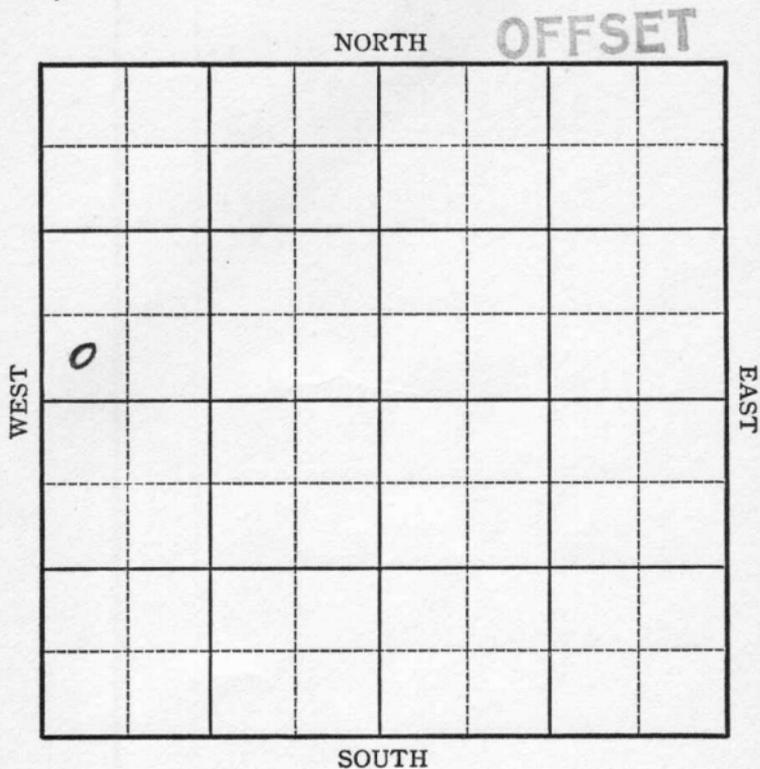

Sec. 36 Twp. 19 R. 11-W

Well No. #7 Schmidt Farm

Texas Company


         Ft. from N. Line

330 Ft. from S. Line

         Ft. from E. Line

330 Ft. from W. Line

*Special*

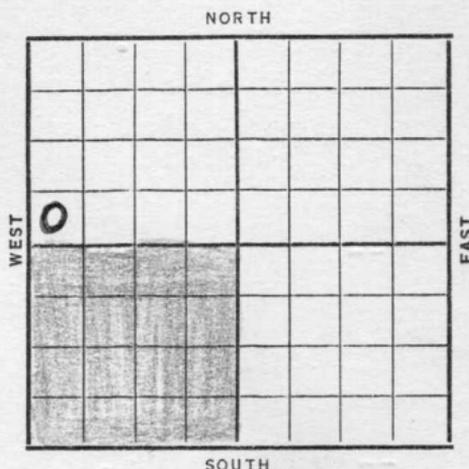

Date	Elev. 1766	REPORT
1937		
10/20		Location
10/29		12" @ 163'. WOC.
11/5		Dlg. 3022 (Tel)
11/8		Top Siliceous <del>3290</del> <sup>3300</sup> TD <del>3292</del> <sup>3302</sup> show oil Waiting on pipe (Tel)
11/12		Correction Top Siliceous 3300 T.D. 3302 7" 3300 WOC (Tel)
11/18		T.D. 3325 No show Shut down for orders (Tel)
11/19		1/2 bailer oil 3327 T.D. 3329 No increase oil Made 2 bailers water Waiting orders (Tel)
11/22		T.D. 3329 Water PB to 3324 1000 acid 1500# pressure Let set 18 hrs. Still had 75# pressure Running rods to test (Tel)
11/23		Shot 20 qts. 300 feet oil in hole 1/2 bailer water Cleaning out (Tel)

OVER

- 11/26--Siliceous 3300 T.D. 3329 water  
 PB to 3324 Acidized 1000 gallons  
 Shot 20 qts.  
 Bailed 10 oil and 10 water in 14 hrs.  
 Bottom hole caving  
 Reacidizing with 1000 gallons (Tel)
- 11/27--Correction--Acidized 2000 gallons  
 Swab 69 bbls. oil and 49 bbls. water  
 Swab to bottom Broke down  
 Will start swabbing after repairs (Tel)
- 11/29--Swab 5 bbls. oil & estimate 50 bbls.  
 water last 24 hours (Tel)
- 12/1--Shot 60 qts. Cleaning out (Tel)
- 12/9--After 60 qt. shot had 1000 feet fluid  
 Swab 12 bbls. oil and 24 bbls. water  
 in 2 hrs. Shut down orders (Tel)
- 12/17 " " " "
- 12/24 " " " "
- 
- 12/29 12" @ 163'.  
 7" @ 3300'.  
 Arb. 3300'.  
 T.D. 3328'.  
 P.B. 3324'.  
 3000 acid.  
 Shot 60 qts.

ABANDONED

Map No. \_\_\_\_\_ Sec. 36 Twp. 19 R. 11W

Well No. 7 Schmidt

Texas Company

Contractor

FIRST REPORT  
SW NW

SECTION PLAT

0			

\_\_\_\_\_ Ft. from N. Line

330 Ft. from S. Line

\_\_\_\_\_ Ft. from E. Line

330 Ft. from W. Line

Special

Location X

Rig up \_\_\_\_\_

Drilling\*and Remarks:

RECORD

Cased \_\_\_\_\_ in., \_\_\_\_\_ ft.

Sand \_\_\_\_\_

Gas \_\_\_\_\_

Oil \_\_\_\_\_

Total Depth \_\_\_\_\_

PRODUCTION

1st 24 hrs. Nat. \_\_\_\_\_

1st 24 hrs. after shot \_\_\_\_\_

Gas \_\_\_\_\_ Cu. Ft.

Dry Hole \_\_\_\_\_

Abandoned \_\_\_\_\_

Date

OCT 20 1937

19


H. D. Hatfield Scout

Section No. 7  
Map No. 35  
Company  
Contractor

SECTION PLAT


ft. from N. line  
ft. from S. line  
ft. from E. line  
ft. from W. line

*Handwritten signature*

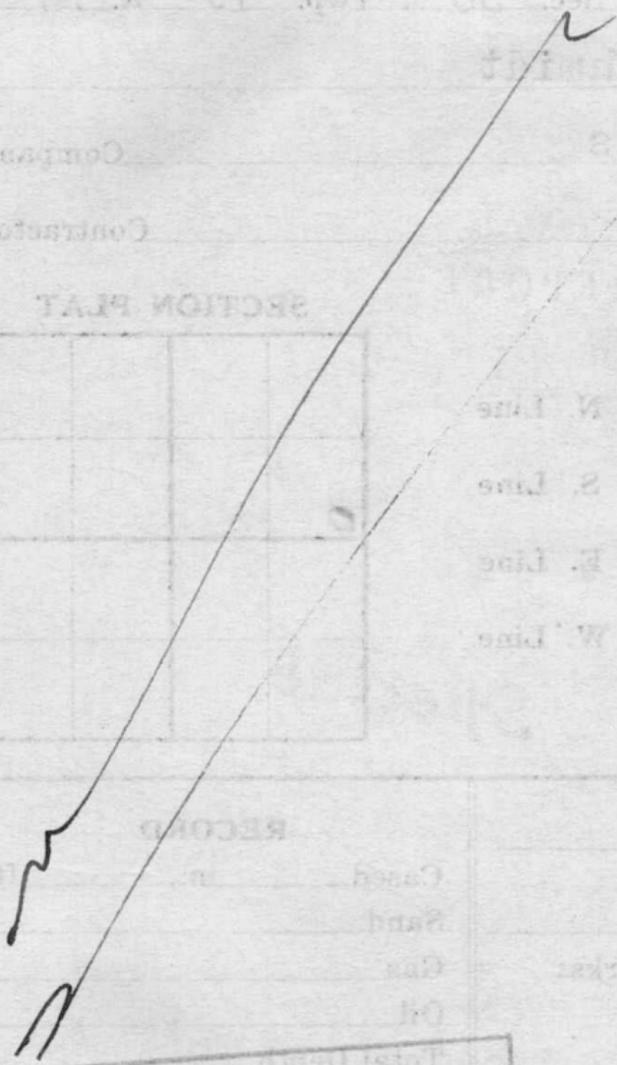

RECORD

- Returned \_\_\_\_\_
- Cards *Paul*
- Tracing *JM*
- France Map *✓*
- Scarborough Map *✓*
- Moody Map *✓*
- Scarborough Plat Book \_\_\_\_\_
- Moody Plat Book \_\_\_\_\_

*Handwritten signature*

Barton KANSAS

Map No. 46 Sec. 36 Twp. 19 R. 11W

Well No. 7 Schmidt

Texas

Company

Contractor

SECTION PLAT

SW NW

Ft. from N. Line

330 Ft. from S. Line

Ft. from E. Line

330 Ft. from W. Line

0			

ABANDONED

Location \_\_\_\_\_

Rig up \_\_\_\_\_

Drilling and Remarks:

*P.B. 3324  
3000 Acid  
shot 60 gts*

*DVA*

*12" - 163*  
RECORD

Cased 7 in., 3300 ft.

Sand Arb 3300

Gas \_\_\_\_\_

Oil \_\_\_\_\_

Total Depth 3328

PRODUCTION

1st 24 hrs. Nat. \_\_\_\_\_

1st 24 hrs. after shot \_\_\_\_\_

Gas \_\_\_\_\_ Cu. Ft.

Dry Hole \_\_\_\_\_

Abandoned \_\_\_\_\_

Date

DEC 29 1937 19

H. D. Hatfield

Scout

WELL No. 780  
Map No. 350  
SECTION PLAT


RECORD

*Jew*

- |                       |             |
|-----------------------|-------------|
| Returned              |             |
| Cards                 | <i>Paul</i> |
| Tracing               | <i>JW</i>   |
| France Map            |             |
| Scarborough Map       | <i>Jew</i>  |
| Moody Map             |             |
| Scarborough Plat Book |             |
| Moody Plat Book       |             |