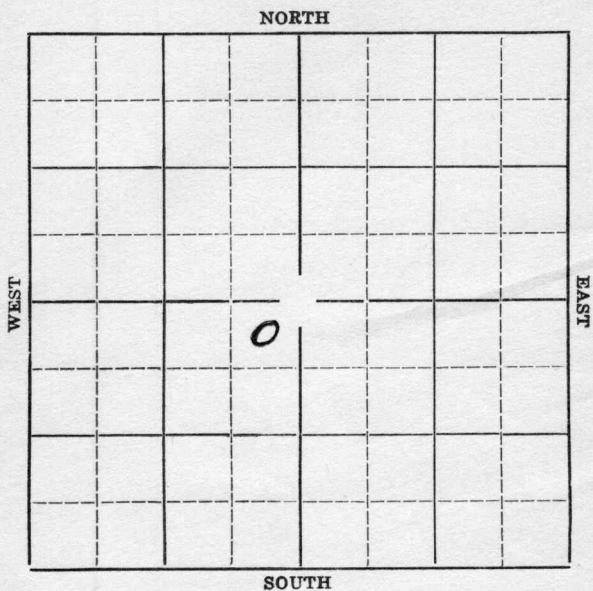


Section 36 Township 19 Range 11-WWell Number 6-SchmidtCompany Mid-Continent Pet. Corp.

3386
3278

106

Map No. _____ Sec. **36** Twp. **19** R. **11W**

Well No. **#6 Schmidt** Farm _____

Mid-Continent Pet Corp. Company _____


330' Ft. from N. Line

_____ Ft. from S. Line

330' Ft. from E. Line

_____ Ft. from W. Line

Elev. 1763

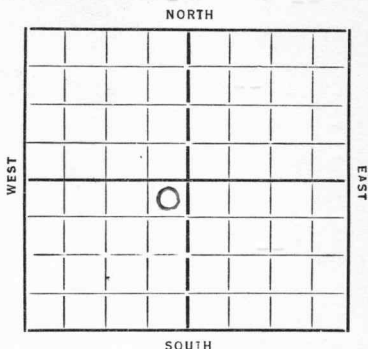

Date **1936** REPORT

5/6 Location.

5/14 Rig on ground.

5/22 Dlg. 2210 (Tel)

5/25 Dlg. 2700 (Tel)

6/1 Top Siliceous 3278

Total Depth 3283

Good saturation from 3282-83

Setting 7" 3279 (Tel)

6/3 Rust (Tel)

6/12 Drilled plug Hole full oil

May deepen (Tel)

6/13 Total Depth 3287

Will swab and test (Tel)

6/15 Lost swab Fished swab out

Cleaning out and will run liner (Tel)

6/19 Potential 728 bbls.

Will bail and retake (Telegram)

7/1/36-Sil. 3278'. T.D. 3287'.

Pot. 728 bbls oil. 2% Water Nat.

COMPLETED

(OVER)

8/18--60 day retest 510 bbls. (Telegram)

10/14/36--6 months field retest: (Tel)
#2 & #6 Schmidt together made 2,778 bbls.--New
#2 & #6 " " " 2,454 " --Old
324 " Inc.

10/4/37--New potential 203 bbls. (Tel)

KANSAS

Map No. 46 Sec. 36 Twp. 19 R. 11WWell No. 6 SchmidMid-Continent Oil Co. Company

Contractor

SECTION PLAT

330 Ft. from N. Line

Ft. from S. Line

330 Ft. from E. Line

Ft. from W. Line

	o		

FIRST REPORT

Location ✓

Rig up

Drilling and Remarks:

RECORD

Cased in., ft.Sand Gas Oil Total Depth

PRODUCTION

1st 24 hrs. Nat. 1st 24 hrs. after shot Gas Cu. Ft.Dry Hole Abandoned

Date

MAY 6 1936

192

S. J. LEWIS

Scout

SECTION PLAT

RECORD

Location

Big

Drilling and

Total Depth

Returned

Cards

Tracing

Francis M

Scarborough

Moody

Scarborough Plat Book

Moody Plat Book


Map No. 46 Sec. 36 Twp. 19 R. 11WWell No. 6 SchmidtMid-Continent & P. & C. Company

Contractor

SECTION PLAT

	6		

320 Ft. from N. Line

_____ Ft. from S. Line

320 Ft. from E. Line

_____ Ft. from W. Line

COMPLETED

Location _____

Rig up _____

Drilling and Remarks:

Oil 3278P. & C. 728 oil2% WaterNat.

RECORD

Cased _____ in., _____ ft.

Sand _____

Gas _____

Oil _____

Total Depth 3287

PRODUCTION

1st 24 hrs. Nat. _____

1st 24 hrs. after shot _____

Gas _____ Cu. Ft.

Dry Hole _____

Abandoned _____

Date

JUL 1 1936S. J. LEWIS Scout

Returned

Cards

Tracing

France Map

Scarborough Map

Moody Map

Scarborough Plat Book

Moody Plat Book