

DRILLING WELL COMPLETION REPORT

Well No. Six (6) Farm Name Carl Schmidt
Date ~~drilling~~ completed June 25, 1936
Description SW $\frac{1}{4}$ Section 36-19S-11W
County Barton, State Kansas
Initial production 728 bbls. Total depth 3,287 feet
Initial volume _____ cu. ft. _____ lbs. rock pressure
Pipe Line Company _____
Gas Company _____
Remarks: Production 728 barrels based on 24 hour potential test
MCPC interest - All
Allowed 40.25 barrels daily




Accounting Dept.
Rental Dept.
Scouting Dept.
Engineering Dept.
Legal Dept.
Lease Inventory Man
Tax Dept.
Geological
File

LOCATION NOTICE

TULSA, OKLA., May 5, 1936 193WELL NO. SIX (6) ON CARL SCHMIDT FARM

WILL BE AS FOLLOWS:

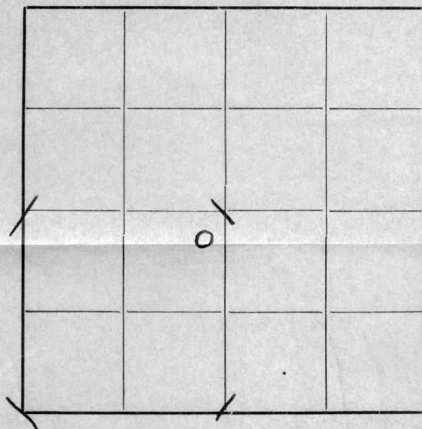

330 FEET FROM NORTH LINE

330 FEET FROM EAST LINE

FEET FROM SOUTH LINE

FEET FROM WEST LINE

IN SW 1/4 SEC. 36 TWP. 19S RANGE 11WBarton COUNTY, STATE OF Kansas

REMARKS:

COPIES TO

SIGNED

DISTRICT SUPT.
 ACCOUNTING DEPT.
 RENTAL DEPT.
 SCOUTING DEPT. ✓
 ENGINEERING DEPT.
 LEGAL DEPT.
 CLAIM DEPT.
 TAX DEPT.
 GEOLOGICAL DEPT.
 FILE
 LEASE INVENTORY

Smart
well group
June