


Map No. KANSAS Sec. 36 Twp. 19 R. 11W
Well No. #6 F.J. Wendel Farm
Gulf. Company

NORTH

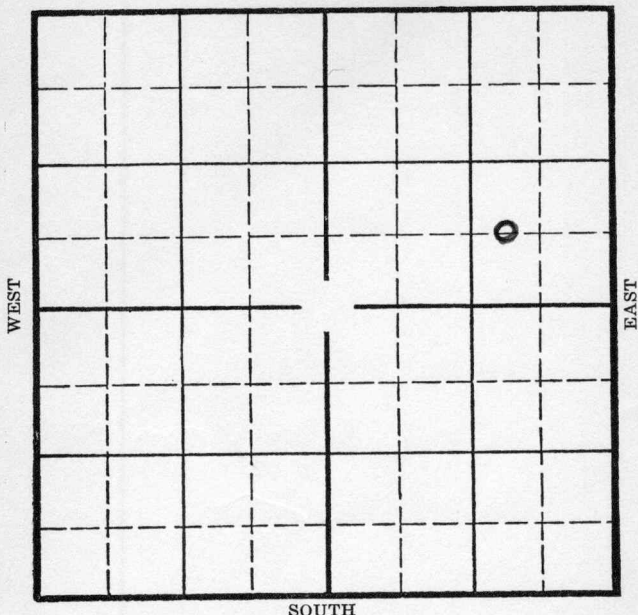

Location _____
Drilling Remarks _____

Rig Up-----
Drilling Remarks

RECORD

Cased _____ in. _____ ft.
Sand _____
Gas _____
Oil _____
Total Depth _____

PRODUCTION

1st 24 hrs. Nat.
1st 24 hrs. after shot
Gas cu. ft.
Dry Hole
Abandoned

Map No. _____ Sec. 36 Twp. 19-S R. 11-W

Well No. 6--F.J. Wendel Farm _____


Gulf Company _____

_____ Ft. from N. Line

660 _____ Ft. from S. Line

990 _____ Ft. from E. Line

_____ Ft. from W. Line

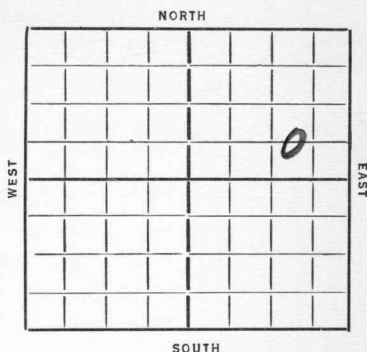

Date
1936

REPORT

3/25 Location

4/2 Drlg. 1700'

4/10 Drlg. 3110'

4/16 Sil 3276½' T.D. 3279'

4/23 T.D. 1003 bbls Nat. 1000 acid.
Testing.

4/29/36- Sil 3276½'

T.D. 3287' 1000 acid.

Potential 1157 bbls.

COMPLETED

Map No. 46 Sec. 36 Twp. 19 R. 11WWell No. 6 F. J. Hendel.G. J. Company

Contractor

SECTION PLAT

Ft. from N. Line

660 Ft. from S. Line990 Ft. from E. Line

Ft. from W. Line

			o

FIRST REPORTS

Location ✓

Rig up

Drilling and Remarks:

RECORD

Cased in., ft.

Sand

Gas

Oil

Total Depth

PRODUCTION

1st 24 hrs. Nat.

1st 24 hrs. after shot

Gas Cu. Ft.

Dry Hole

Abandoned

Date

3/25/36 192 S. J. LEWIS Scout

check we show continental
owns this 40 acres and they
have a number six well dlg
in it.

Sam

now O.K.

H.A.N.

[Large handwritten signature/initials]

*check our land
continental owned
40 acres
have a #6
well*

Returned	<i>[Signature]</i>
Cards	<i>[Signature]</i>
Tracing	<i>[Signature]</i>
France Map	<i>[Signature]</i>
Scarborough Map	<i>[Signature]</i>
Moody Map	<i>[Signature]</i>
Scarborough Plat Book	<i>[Signature]</i>
Moody Plat Book	<i>[Signature]</i>

KANSAS

Map No. 46 Sec. 36 Twp. 19 R. 11 NWell No. 6 F. J. WendelS. J. Lewis Company

Contractor

SECTION PLAT

			0

Ft. from N. Line

660 Ft. from S. Line990 Ft. from E. Line

Ft. from W. Line

COMPLETED

RECORD

Location

Cased _____ in., _____ ft.

Rig up

Sand

Drilling and Remarks:

Gas

Oil

Total Depth 3287

PRODUCTION

1st 24 hrs. Nat. _____

1st 24 hrs. after shot _____

Gas _____ Cu. Ft.

Dry Hole _____

Abandoned _____

Date

APR 29 1936

192


S. J. LEWIS

Scout

Map No. _____

Well No. _____

SECTION MAP

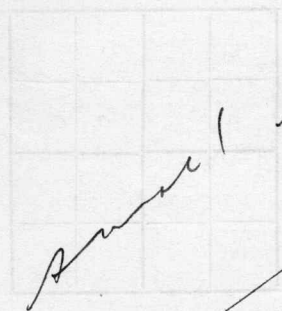

Handwritten signature/initials

Returned	_____
Cards	<i>Sh</i>
Tracing	<i>Joe</i>
France Map	_____
Scarborough	<i>[Signature]</i>
Moody	_____
Scarborough Flat Book	_____
Moody Flat Book	_____