


Section 36 Township 19 Range 11-W

Well Number 12-Risse

Company Continental

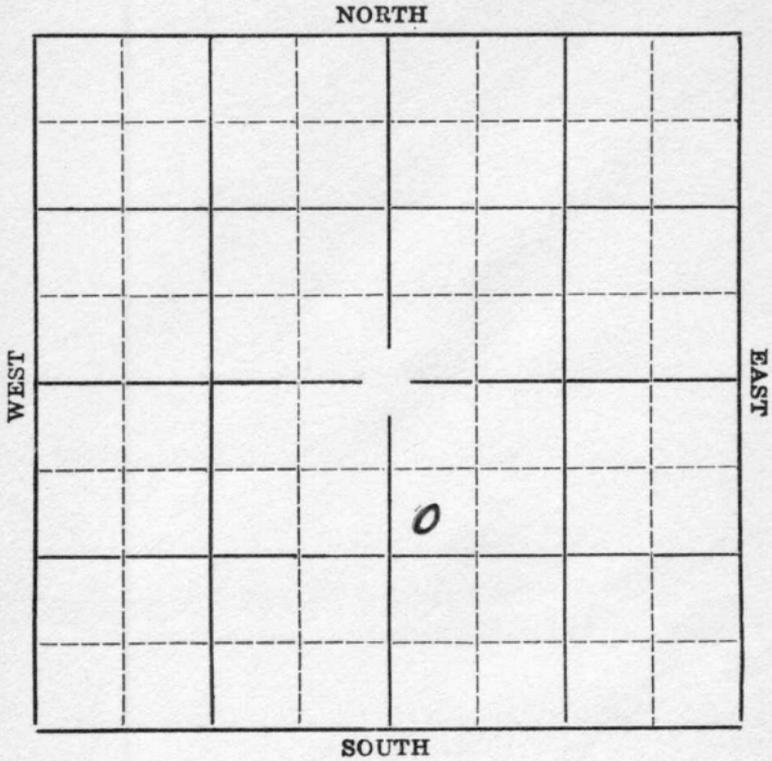

Map No. **KANSAS** Sec. 36 Twp. 19 R. 11W

Well No. #12 Risse Farm


Continental Company

1078' Ft. from N. Line

\_\_\_\_\_ Ft. from S. Line

\_\_\_\_\_ Ft. from E. Line

330' Ft. from W. Line

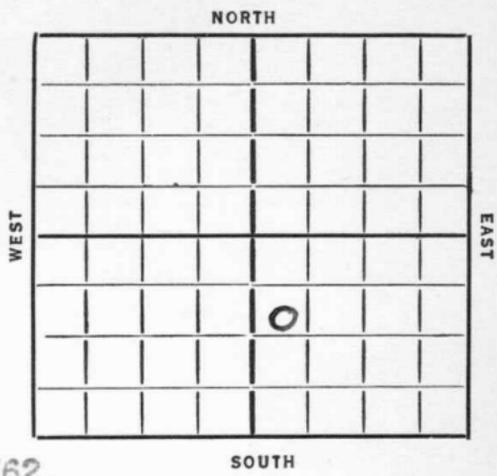

Elev. 1762

Date	REPORT
<u>1936</u>	
<u>5/13</u>	Ponds.
<u>5/21</u>	<u>12 1/2" @ 171' WOC.</u>
<u>5/28</u>	<u>Drlg. 2400'.</u>
<u>6/4</u>	<u>Sil. 3278'-Set 7". T.D. 3282'.</u>
	<u>Rig up standard tools.</u>
<u>6/11</u>	<u>T.D. 3287'. 2900' oil in 3 hours.</u>
<u>6/17/36</u>	<u>Sil. 3278'.</u>
	<u>T.D. 3292'. 4000 Acid.</u>
	<u>Potential 1842 bbls of oil.</u>
	<b>COMPLETED</b>

KANSAS

Map No. 46 Sec. 36 Twp. 19 R. 11W

Well No. 12 Riss

Continental Company

Contractor

SECTION PLAT

		o	

1078 Ft. from N. Line

\_\_\_\_\_ Ft. from S. Line

\_\_\_\_\_ Ft. from E. Line

330 Ft. from W. Line

FIRST REPORT

Location \_\_\_\_\_

Rig up \_\_\_\_\_

Drilling and Remarks:

Ponds

RECORD

Cased \_\_\_\_\_ in., \_\_\_\_\_ ft.

Sand \_\_\_\_\_

Gas \_\_\_\_\_

Oil \_\_\_\_\_

Total Depth \_\_\_\_\_

PRODUCTION

1st 24 hrs. Nat. \_\_\_\_\_

1st 24 hrs. after shot \_\_\_\_\_

Gas \_\_\_\_\_ Cu. Ft.

Dry Hole \_\_\_\_\_

Abandoned \_\_\_\_\_

Date

MAY 13 1936

19

S. J. LEWIS

Scout

*Barlow*

Map No. 46 Sec. 36 Twp. 19 R. 11W

Well No. 12 Rise

Continental Company

Contractor

SECTION PLAT

		0	

1078 Ft. from N. Line

\_\_\_\_\_ Ft. from S. Line

\_\_\_\_\_ Ft. from E. Line

330 Ft. from W. Line

COMPLETED

Location \_\_\_\_\_

Rig up \_\_\_\_\_

Drilling and Remarks:

*Sil 3278.*  
*4000 acid*  
*Post 1842886*

RECORD

Cased \_\_\_\_\_ in., \_\_\_\_\_ ft.

Sand \_\_\_\_\_

Gas \_\_\_\_\_

Oil \_\_\_\_\_

Total Depth 3252

PRODUCTION

1st 24 hrs. Nat. \_\_\_\_\_

1st 24 hrs. after shot \_\_\_\_\_

Gas \_\_\_\_\_ Cu. Ft.

Dry Hole \_\_\_\_\_

Abandoned \_\_\_\_\_

Date

JUN 17 1936

S. J. LEWIS Scout