


Map No. KANSAS Sec. 36 Twp. 19 R. 11-W

Well No. #8 Risse Farm _____
Continental Company _____

NORTH

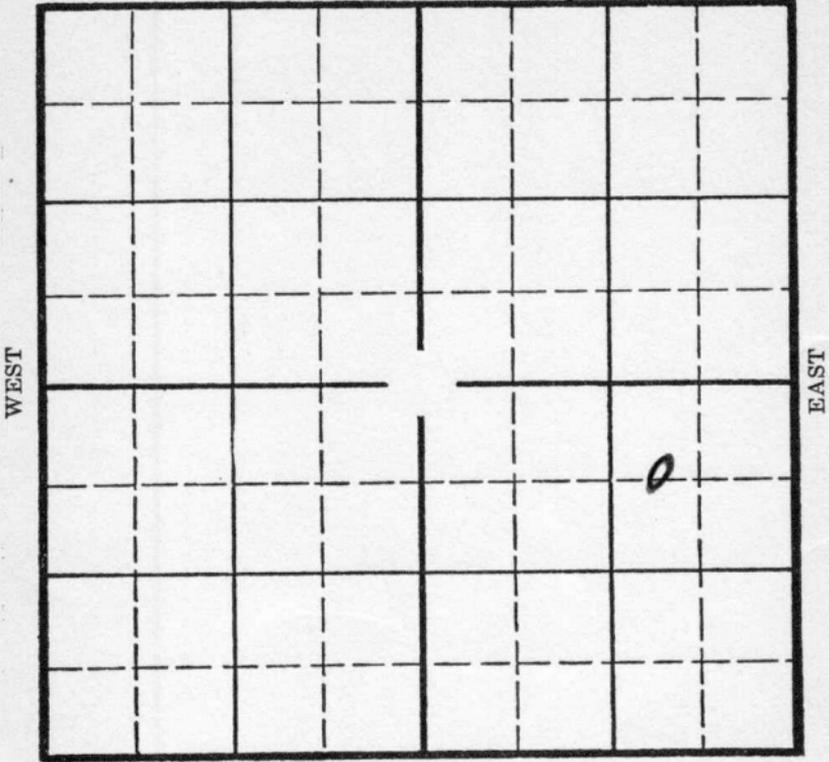

SOUTH

Location _____
Drilling Remarks _____

Rig Up _____
Drilling Remarks _____

RECORD

PRODUCTION

Cased _____ in. _____ ft.
Sand _____
Gas _____
Oil _____
Total Depth _____

1st 24 hrs. Nat. _____
1st 24 hrs. after shot _____
Gas _____ cu. ft. _____
Dry Hole _____
Abandoned _____

KANSAS

Map No. _____ Sec. 36 Twp. 19 R. 11-W

Well No. 8-Risse Farm _____


Continental Company _____

660 Ft. from N. Line

_____ Ft. from S. Line

990 Ft. from E. Line

_____ Ft. from W. Line

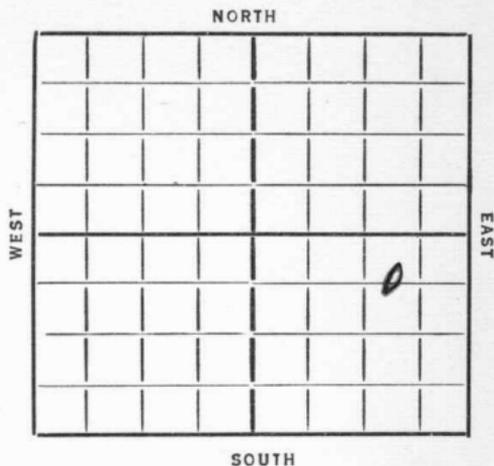

Elev. 1761

Date
1936

REPORT

3/25 Cellar

4/2 Spud 70'

4/10 Drlg. 1645'

4/16 Drlg. 2391'

4/23 Sil. 3264', 7" @ 3265' T.D. 3266'

4/30 T.D. 3275'-2800' oil in 1 hour.

5/6/36- Sil. 3264'

T.D. 3280'

4000 acid.

1983 bbls.

COMPLETED

Map No. 46 Sec. 36 Twp. 19 R. 11W

Well No. 5 Russ

Continental Company

Contractor

SECTION PLAT

660 Ft. from N. Line

..... Ft. from S. Line

990 Ft. from E. Line

..... Ft. from W. Line

			0

FIRST REPORTS

Location.....

Rig up.....

Drilling and Remarks:

Cellar

RECORD

Cased..... in., ft.

Sand.....

Gas.....

Oil.....

Total Depth.....

PRODUCTION

1st 24 hrs. Nat.....

1st 24 hrs. after shot.....

Gas..... Cu. Ft.

Dry Hole.....

Abandoned.....

Date

3/25/26 192.....

S. J. LEWIS

Scout

Map No. 46 Sec. 36 Twp. 19 R. 11W

Well No. J Rise

Continental Company

Contractor

SECTION PLAT

660 Ft. from N. Line

_____ Ft. from S. Line

990 Ft. from E. Line

_____ Ft. from W. Line

		.	0

COMPLETED

Location _____

Rig up _____

Drilling and Remarks:

Sil 3264
400 acid
1983 H/W.

RECORD

Cased _____ in., _____ ft.

Sand _____

Gas _____

Oil _____

Total Depth 3280

PRODUCTION

1st 24 hrs. Nat. _____

1st 24 hrs. after shot _____

Gas _____ Cu. Ft.

Dry Hole _____

Abandoned _____

Date

MAY 6 1936 19

S. J. LEWIS Scout