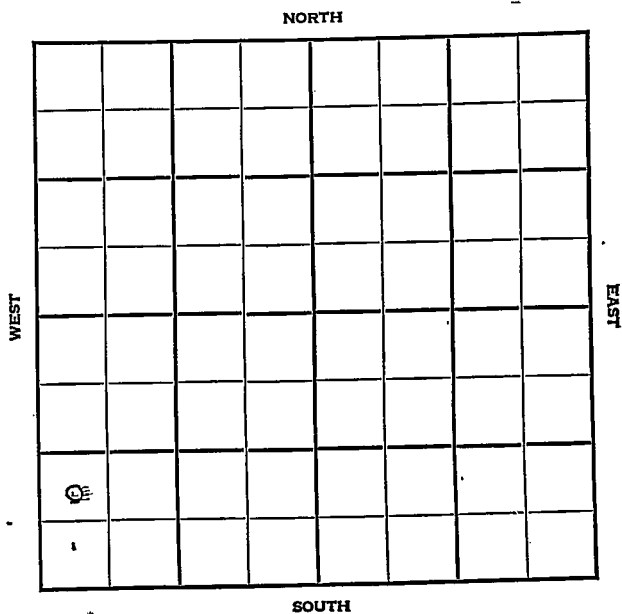


KANSAS

Barton

Section 36 Township 19 Range 11-WWell No. #1 EhhardtCompany E Adair

KANSAS HOT FILE

Sec. 36 Twp. 19 R. 11W

Well No. #1 Ebhardt Farm

E. Adair Company


Silica Pool

 Ft. from N. Line

990' Ft. from S. Line

 Ft. from E. Line

330' Ft. from W. Line

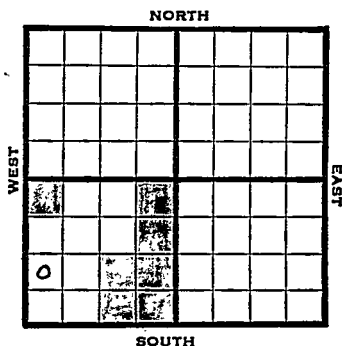

NW SW SW

1948 Eli 1766' REPORT

7/8	Surface Hole
7/14	RUST
7/21	Arb. 3292-95
	TD 3295'
	5" @ 3293'
7/28	"
8/4	"
8/11	"
8/18	"
8/25	TD 3307' 500 acid
9/1	1500 acid
	Swb 1/2 bbl oil & 3 W PH
9/8	"
9/15	Arb. 3292'
	5" @ 3293'
	TD 3308'
	2000 acid
	Aband.
	ABANDONED

Map No. _____ Sec. 36 Twp. 19 R. 11W

Well No. 1 Ebhardt

E. Adair Company

FIRST REPORT

Contractor

NW SW SW

SECTION PLAT

_____ Ft. from N. Line

990 Ft. from S. Line

_____ Ft. from E. Line

330 Ft. from W. Line

Barton County

Location _____

Rig up _____

Drilling and Remarks:

surface hole

RECORD

Cased _____ in., _____ ft.

Sand _____

Gas _____

Oil _____

Total Depth _____

PRODUCTION

1st 24 hrs. Nat. _____

1st 24 hrs. after shot _____

Gas _____ Cu. Ft.

Dry Hole _____

Abandoned _____

Date

JUL 8 1948

19

S. J. LEWIS

Scout

