


Section 36 Township 19 Range 11-W

Well Number 5-Matzek

Company Phillips Pet.

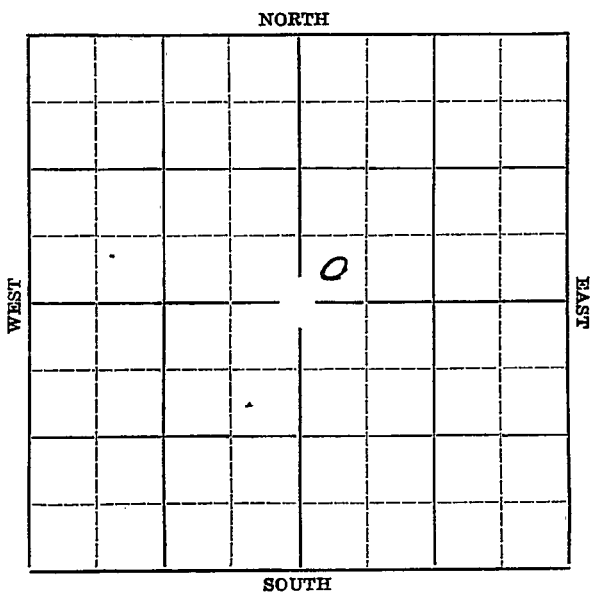

KANSAS

Map No. \_\_\_\_\_ Sec. 36 Twp. 19 R. 11W

Well No. #5 Matzek Farm \_\_\_\_\_

Phillips Pet. Company


NORTH

\_\_\_\_\_ Ft. from N. Line

330' Ft. from S. Line

\_\_\_\_\_ Ft. from E. Line

330' Ft. from W. Line

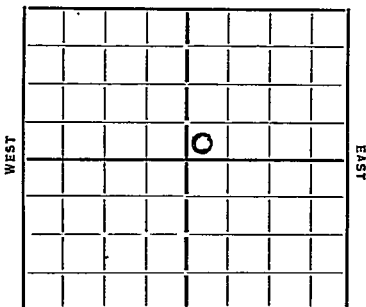

Elev. 1764

Date 1936 REPORT

5/6 Rig.

5/14 Rigging up.

5/21 Shut down.

5/28 --

6/4 Surface hole.

6/11 Drl g. 2602'.

7/1/36-Sil. 3275'.

T.D. 3295'.

1483 bbls of oil natural.

**COMPLETED**

JAS

Map No. 46 Sec. 36 Twp. 17 R. 11 W.

Well No. 5 Matzek.

Phillips P & C Company

Contractor

**SECTION PLAT**

..... Ft. from N. Line

330 Ft. from S. Line

..... Ft. from E. Line

330 Ft. from W. Line

		o	

**FIRST REPORT**

Location.....

Rig up.....

Drilling and Remarks:

*Rig*

**RECORD**

Cased..... in., ..... ft.

Sand.....

Gas.....

Oil.....

Total Depth.....

**PRODUCTION**

1st 24 hrs. Nat.....

1st 24 hrs. after shot.....

Gas..... Cu. Ft.

Dry Hole.....

Abandoned.....

Date

MAY 6 1936

S. J. LEWIS

Map No. 46 Sec. 36 Twp. 19 R. 11W

Well No. 5 Martzok

Phillips Company

Contractor

SECTION PLAT

		0	

\_\_\_\_\_ Ft. from N. Line

330 Ft. from S. Line

\_\_\_\_\_ Ft. from E. Line

330 Ft. from W. Line

COMPLETED

Location \_\_\_\_\_

Rig up \_\_\_\_\_

Drilling and Remarks:

Sil 3275  
1483 Nat.

RECORD

Cased \_\_\_\_\_ in., \_\_\_\_\_ ft.

Sand \_\_\_\_\_

Gas \_\_\_\_\_

Oil \_\_\_\_\_

Total Depth 3295

PRODUCTION

1st 24 hrs. Nat. \_\_\_\_\_

1st 24 hrs. after shot. \_\_\_\_\_

Gas \_\_\_\_\_ Cu. Ft.

Dry Hole \_\_\_\_\_

Abandoned \_\_\_\_\_

Date

JUL 1 1936 19

S. J. LEWIS

Scout