

Barton
19 R. 11W

Map No. 13 Sec. 36 Twp. 19 R. 11W

Well No. 3- Match Farm


Phillips Company

1155 Ft. from N. Line

_____ Ft. from S. Line

990 Ft. from E. Line

_____ Ft. from W. Line

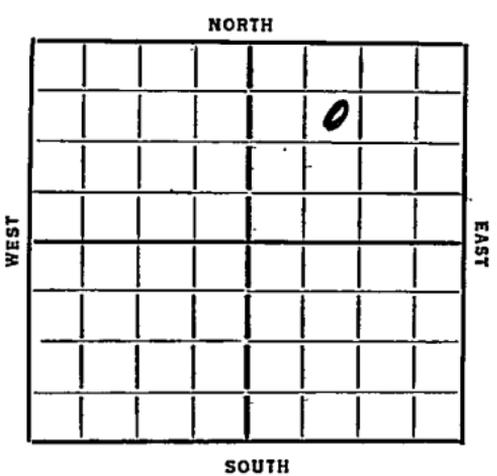

REPORT

1936

3/11

B. R.

3/20

15" - 73' WOC.

3/27

Drlg. 2790'

4/2

T. Sil. and 7" - 3305' T.D. 3307'
WOC.

4/4

Water at 3317 T.D. 3322

Filled up 1500 feet fluid in 30 hrs. (Tel)

4/16

Potential 123 oil 27 water. Will
Acidize.

4/23

1000 gal. acid. 134 oil 113 water
13 hours.

4/29

36 - Sil. 3305'

T.D. 3322'

1000 acid.

99 oil.

250 water.

COMPLETED

Map No. 46 Sec. 36 Twp. 19 R. 11W

Well No. 3-Matzek

Phillips Company
 Contractor

FIRST REPORTS

1155 Ft. from N. Line
 _____ Ft. from S. Line
990 Ft. from E. Line
 _____ Ft. from W. Line

SECTION PLAT

		0	

Location _____
 Rig up _____
 Drilling and Remarks:

BR

RECORD

Cased _____ in., _____ ft.
 Sand _____
 Gas _____
 Oil _____
 Total Depth _____

PRODUCTION

1st 24 hrs. Nat. _____
 1st 24 hrs. after shot _____
 Gas _____ Cu. Ft.
 Dry Hole _____
 Abandoned _____

Date 3-11-36 192 _____

ORVAL MANNSCHRECK
 Scout

KANSAS

Map No. 46 Sec. 36 Twp. 19 R. 11W

Well No. 3 Mateick

Phillips Company

Contractor

1153 Ft. from N. Line
..... Ft. from S. Line
990 Ft. from E. Line
..... Ft. from W. Line

SECTION PLAT

		0	

COMPLETED

RECORD

Location.....

Cased.....in.,ft.

Rig up.....

Sand.....

Drilling and Remarks:

Gas.....

Oil 3305'
1000 acid
99 Oil
250 Water

Oil.....

Total Depth 3222

PRODUCTION

1st 24 hrs. Nat.....

1st 24 hrs. after shot.....

Gas..... Cu. Ft.

Dry Hole.....

Abandoned.....

Date

APR 20 1936

C. J. LEWIS Scout