

Map No. **KANSAS** Sec. **36** Twp. **19** R. **11-W**
 Well No. **#2 Matzek** Farm
Phillips Pet. Company

NORTH

WEST

EAST

SOUTH

Location

Drilling Remarks

Rig Up

Drilling Remarks

RECORD

Cased _____ in. _____ ft.

Sand _____

Gas _____

Oil _____

Total Depth _____

PRODUCTION

1st 24 hrs. Nat. _____

1st 24 hrs. after shot _____

Gas _____ cu. ft. _____

Dry Hole _____

Abandoned _____

Map No. KANSAS Sec. 36 Twp. 19 R. 11W
Well No. 2- Matych Farm
Phillips Pet Company


330 Ft. from N. Line

_____ Ft. from S. Line

_____ Ft. from E. Line

330 Ft. from W. Line

OFFSET

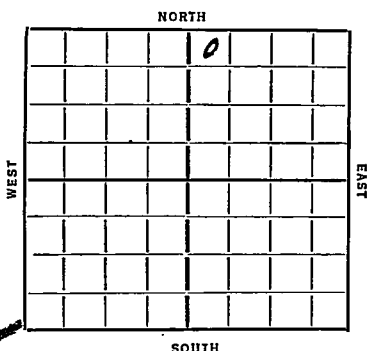

1936

Elev. 1766

REPORT

3/4

Ran up.

3/13

all 2100

12" 182

3/17

Top siliceous

~~3284~~ 3284

Ran pipe (Tel)

3/20

T. Sil. 3284 7"-3284 T.D. 3286

RUST.

3/27

Pay 3293-98 T.D. 900' oil- 2½ hrs.

1400'- 7hrs. 2000'-14hrs. HFO-18hrs.

4/2

794' bbls natural. 1000 acid.

4/6

Potential 2004 bbls. (Tel)

4/8

Sil 3284

TD 3298

1000 acid

Pot 2014 Bbls Oil

COMPLETED

KANSAS

Map No. 46 Sec. 36 Twp. 19 R. 11WWell No. 2-MatzekPhillips pet. Company

Contractor

FIRST REPORTS

330 Ft. from N. Line

Ft. from S. Line

Ft. from E. Line

330 Ft. from W. Lineoff set

SECTION PLAT

		0	

Location

Rig up

Drilling and Remarks:

Rigs up

RECORD

Cased.....in., ...ft.

Sand.....

Gas.....

Oil.....

Total Depth.....

PRODUCTION

1st 24 hrs. Nat.....

1st 24 hrs. after shot.....

Gas.....Cu. Ft.

Dry Hole.....

Abandoned.....

Date

3-4-36 192..... ORVAL MANNSCHRECK Scout

Map No. 46 Sec. 36 Twp. 19 R. 11WWell No. 2 MatzekPhillips Co. Company

Contractor

SECTION PLAT

330 Ft. from N. Line

Ft. from S. Line

Ft. from E. Line

330 Ft. from W. Line

		0	

COMPLETE

Location

Rig up

Drilling and Remarks:

Oil 8284
1000 acid
Potential
2014

RECORD

Cased _____ in., _____ ft.

Sand _____

Gas _____

Oil _____

Total Depth 3295

PRODUCTION

1st 24 hrs. Nat. _____

1st 24 hrs. after shot _____

Gas _____ Cu. Ft.

Dry Hole _____

Abandoned _____

Date

4/8/36 192

S. J. LEWIS Scout