


Map No. 1-36 Sec. 36 Twp. 19 R. 11 W
 Well No. Phillips Farm Phillips Company

NORTH

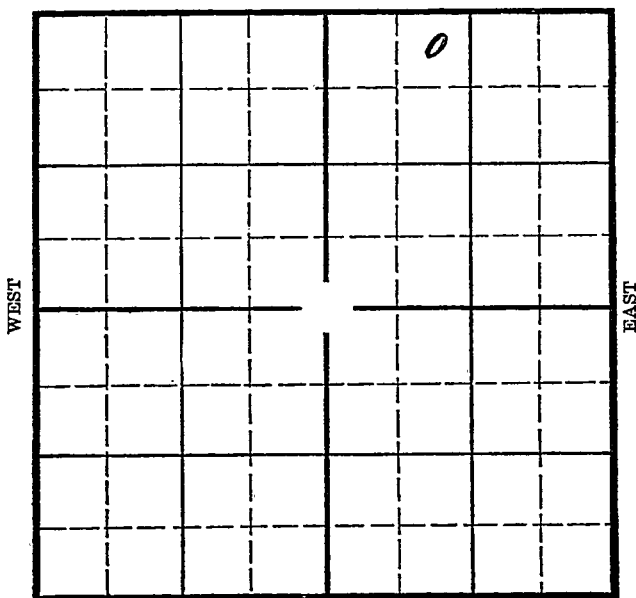

SOUTH

Location _____

Drilling Remarks _____

RECORD

Cased _____ in. _____ ft.

Sand _____

Gas _____

Oil _____

Total Depth _____

Rig Up _____

Drilling Remarks _____

PRODUCTION

1st 24 hrs. Nat. _____

1st 24 hrs. after shot _____

Gas _____ cu. ft.

Dry Hole _____

Abandoned _____

KANSAS

Map No. _____ Sec. 36 Twp. 19 R. 11W

Well No. 1- Matzek Farm _____

Phillips Pet

Company _____

330

Ft. from N. Line

Ft. from S. Line

Ft. from E. Line

990

Ft. from W. Line

Elev. 1764

NORTH

WEST

EAST

SOUTH

REPORT

1936

1/22 Dig Well
1/31 Run
2/7 Dig 815 12" 175
2/14 " 4838 7" 3281
2/20 Top Siliceous 3279
Oil 3284-86 TD 3287
filled up 1750' Oil 45 Min
" 2500' " in
1 hr & 20 Minutes
Filled up HFO in 4 hrs
2/28 Pumping 1100 Bbls 18 hrs (1936)
Waiting on Tanks
3/4 Oil 3279
TD 3287
1100 Bbls 18 hrs Natural

COMPLETED

KANSAS

Map No. 46 Sec. 36 Twp. 19 R. 11W

Well No. 1- Matzek

Phillips Pet. Company

Contractor

SECTION PLAT

330 Ft. from N. Line

_____ Ft. from S. Line

_____ Ft. from E. Line

990 Ft. from W. Line

FIRST REPORT

		0	

Location _____

Rig up _____

Drilling and Remarks:

Dig cellar

RECORD

Cased _____ in., _____ ft.

Sand _____

Gas _____

Oil _____

Total Depth _____

PRODUCTION

1st 24 hrs. Nat. _____

1st 24 hrs. after shot _____

Gas _____ Cu. Ft.

Dry Hole _____

Abandoned _____

Date

JAN 22 1936

192 _____

Scout

ORIGINAL CHECK

KANSAS

Map No. 46 Sec. 36 Twp. 19 R. 11WWell No. 1-MatzekPhillips Company

Contractor

COMPLETE

SECTION PLAT

330 Ft. from N. Line

Ft. from S. Line

Ft. from E. Line

990 Ft. from W. Lineoffset

		0	

Location

Rig up

Drilling and Remarks:

1100 fbs18 hrs.natural

RECORD

Cased in ft.

Sand Oil 3279

Gas

Oil

Total Depth 3287

PRODUCTION

1st 24 hrs. Nat.

1st 24 hrs. after shot

Gas Cu. Ft.

Dry Hole

Abandoned

Date

3-4-36 192 ORVAL MATZKE Scout