


Map No. **KANSAS** Sec. **36** Twp. **19** R. **11W**
 Well No. **5- Riser** Farm _____
Continental Company _____

NORTH

WEST

EAST

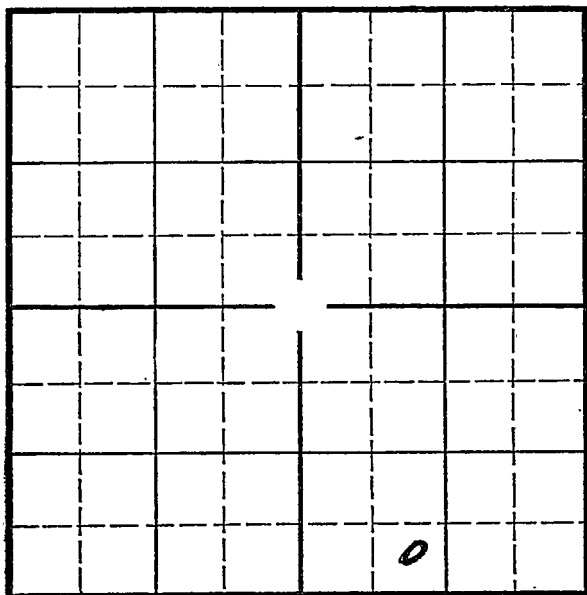

SOUTH

Location _____

Drilling Remarks _____

Rig Up _____

Drilling Remarks _____

RECORD

Cased _____ in. _____ ft.

Sand _____

Gas _____

Oil _____

Total Depth _____

PRODUCTION

1st 24 hrs. Nat. _____

1st 24 hrs. after shot _____

Gas _____ cu. ft. _____

Dry Hole _____

Abandoned _____

Map No. KANSAS Sec. 36 Twp. 19 R. 11W
Well No. 5- Kisse Farm
Continental Company


 Ft. from N. Line

330 Ft. from S. Line

 Ft. from E. Line

990 Ft. from W. Line

Elev. 1762

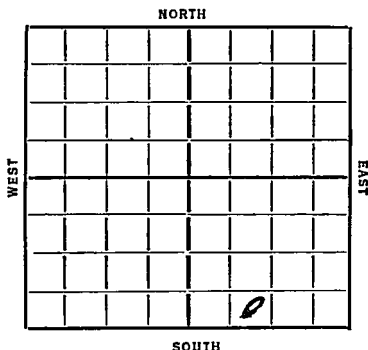

REPORT

1936
2/5 Location

2/14 Cells

2/21 RR

2/28 Run

3/6 Drlg 1060 12" 172

3/13 " 1850

3/20 Drlg. 2935

3/27 7" - 3279 T.D. 3281 RUST.

4/2 Drlg. 3290

4/8 Sil 3279

T.D. 3297

4000 acid
Pot 1816 Bbls.

COMPLETED

KANSAS

Map No. 46 Sec. 36 Twp. 19 R. 11W

Well No. 5-Rise

Continental Company

Contractor

SECTION PLAT

.....Ft. from N. Line

330 Ft. from S. Line

.....Ft. from E. Line

990 Ft. from W. Line

FIRST REPORT

			o

Location ✓

Rig up

Drilling and Remarks:

RECORD

Cased.....in., ...ft.

Sand.....

Gas.....

Oil.....

Total Depth.....

PRODUCTION

1st 24 hrs. Nat.....

1st 24 hrs. after shot.....

Gas.....Cu. Ft.

Dry Hole.....

Abandoned.....

Date

FEB 5 1936

ORVAL MANNSCHRECK

Scout

Map No. 46 Sec. 36 Twp. 19 R. 11WWell No. 5 RisseContinental Company

Contractor

SECTION PLAT

Ft. from N. Line

330 Ft. from S. Line

Ft. from E. Line

990 Ft. from W. Line

COMPLETED

Location

Rig up

Drilling and Remarks:

Oil 32794000 acidPotential1816 8 1/2

RECORD

Cased in., ft.

Sand

Gas

Oil

Total Depth 3297

PRODUCTION

1st 24 hrs. Nat.

1st 24 hrs. after shot

Gas Cu. Ft.

Dry Hole

Abandoned

Date

4/5/36

192

S. J. LEWIS

Scout