

DRILLING WELL COMPLETION REPORT

Well No. FOUR (4) Farm Name CARL SCHMIDT
Date drilling completed May 7, 1936
Description SW 1/4 Sec. 36-19S-11W
County Barton, State Kansas
Initial production 1797 bbls. Total depth 3282 feet
Initial volume _____ cu. ft. _____ lbs. rock pressure
Pipe Line Company _____
Gas Company _____
Remarks: M.C.P.C. interest- ALL
Pot. 1797 bbls. May Daily Allowed 120.93 bbls.




Accounting Dept.
Rental Dept.
Scouting Dept. ✓
Engineering Dept.
Legal Dept.
Lease Inventory Man
Tax Dept.
Geological
File

LOCATION NOTICE

TULSA, OKLA., March 25, 1936 193WELL NO. FOUR (4) ON CARL SCHMIDT FARM

WILL BE AS FOLLOWS:

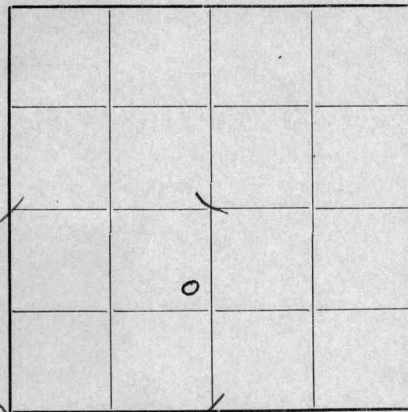

1060 FEET FROM NORTH LINE

330 FEET FROM EAST LINE

1580 FEET FROM SOUTH LINE

FEET FROM WEST LINE

IN SW $\frac{1}{4}$ SEC. 36 TWP. 19S RANGE 11WBarton COUNTY, STATE OF Kansas

REMARKS:

COPIES TO

SIGNED [Signature]

DISTRICT SUPT.
 ACCOUNTING DEPT.
 RENTAL DEPT.
 SCOUTING DEPT. ✓
 ENGINEERING DEPT.
 LEGAL DEPT.
 CLAIM DEPT.
 TAX DEPT.
 GEOLOGICAL DEPT.
 FILE
 LEASE INVENTORY

[Signature]
[Signature]
[Signature]