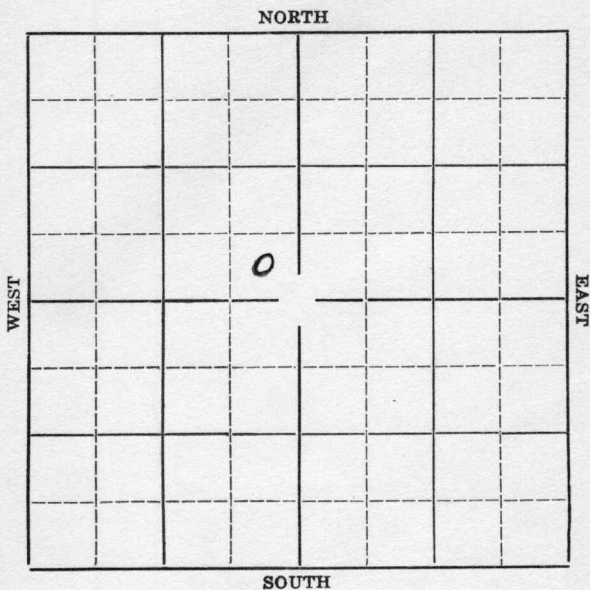


Section 36 Township 19 Range 11-WWell Number 3-SchmidtCompany Texas Oil


Map No. _____ Sec. 36 Twp. 19 R. 11WWell No. #3 Schmidt Farm _____
Texas Oil. Company _____

_____ Ft. from N. Line

330' Ft. from S. Line330' Ft. from E. Line

_____ Ft. from W. Line

Elev. 1765

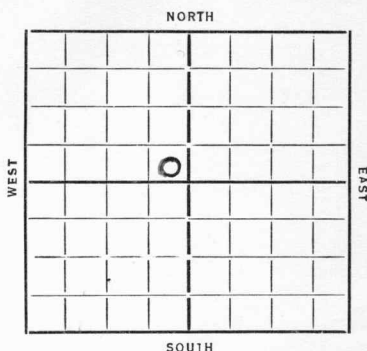Date 1936 REPORT5/6 Location.5/14 -- 5/21-5/28 --6/4 Cellar.6/11 Rigging up.6/18 Drlg. 1775'.6/25 Drlg. 2968'.7/2 Shut down.7/9 Sil. 3287'. Set 7" Drlg. 3306'.
Some oil.7/16 T.D. 3331'. Water. P.B. to 3323'.
Fighting cave.7/23 3320' oil and water shut off.7/30 Shut down.8/6 Siliceous 3287'. P.B. 3220'. Oil
and water shut off. Shut down.8/12 Dry and abandoned (Tel)8/12/36 Sil. 3287'.

P.B. 3322'.

T.D. 3333'.

Water. Dry and abandoned.

ABANDONED

Map No. 46 Sec. 96 Twp. 19 R. 11W

Well No. 3 Schmidt

Texas Oil Company

Contractor

SECTION PLAT

.....Ft. from N. Line

330 Ft. from S. Line

330 Ft. from E. Line

.....Ft. from W. Line

FIRST REPORT

Location ✓

Rig up

Drilling and Remarks:

RECORD

Cased.....in., ...ft.

Sand.....

Gas.....

Oil.....

Total Depth.....

PRODUCTION

1st 24 hrs. Nat.....

1st 24 hrs. after shot.....

Gas.....Cu. Ft.

Dry Hole.....

Abandoned.....

Date

MAY 6 1936

192

C. J. LEWIS

Scout

KANSAS

Map No. 46 Sec. 36 Twp. 19 R. 11WWell No. 3 SchmidtTexas Company

Contractor

SECTION PLAT

 Ft. from N. Line330 Ft. from S. Line330 Ft. from E. Line Ft. from W. Line

ABANDONED

Location Rig up

Drilling and Remarks:

S. C. 3287P.B. 3322.WaterDYH

RECORD

Cased in., ft.Sand Gas Oil Total Depth 3333

PRODUCTION

1st 24 hrs. Nat. 1st 24 hrs. after shot Gas Cu. Ft.Dry Hole Abandoned

Date

AUG 12 1936 19 S. J. LEWIS Scout