


Map No. **KANSAS** Sec. **36** Twp. **19** R. **11W**
 Well No. **4-River** Farm _____
Continental Company _____

NORTH

WEST

EAST

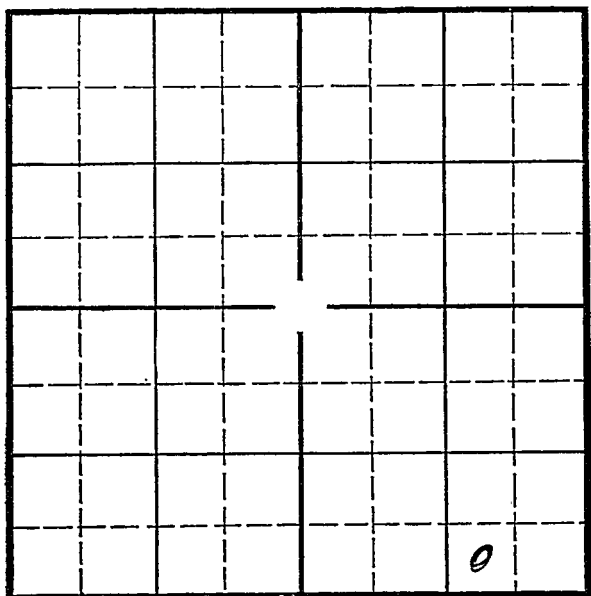

SOUTH

Location _____

Drilling Remarks _____

Rig Up _____

Drilling Remarks _____

RECORD

Cased _____ in. _____ ft.

Sand _____

Gas _____

Oil _____

Total Depth _____

PRODUCTION

1st 24 hrs. Nat. _____

1st 24 hrs. after shot _____

Gas _____ cu. ft. _____

Dry Hole _____

Abandoned _____

KANSAS

Map No. _____ Sec. 26 Twp. 11 R. 11

Well No. 4 - Kiske Farm

Continental Company

Ft. from N. Line

330 Ft. from S. Line

990 Ft. from E. Line

Ft. from W. Line

Elev. 1760

NORTH

WEST

EAST

SOUTH

REPORT

Location

Allen & Gut

BR

14th / 80 woc

delg 27/3

Top Sil. v. ~~FR~~ 7" 3298

TP 3280 Kust

File 3478

TD 3290

2000 acids
1500 ppl

1583 1864.

~~COMPLETED~~

KANSAS

Map No. 46 Sec. 36 Twp. 19 R. 11W

Well No. 4 - Risse

Continental Company

Contractor

SECTION PLAT

.....Ft. from N. Line

330 Ft. from S. Line

990 Ft. from E. Line

.....Ft. from W. Line

FIRST REPORT

Location.....✓

Rig up.....

Drilling and Remarks:

RECORD

Cased.....in., ...ft.

Sand.....

Gas.....

Oil.....

Total Depth.....

PRODUCTION

1st 24 hrs. Nat.....

1st 24 hrs. after shot.....

Gas.....Cu. Ft.

Dry Hole.....

Abandoned.....

Date

FEB 5 1936

192

ORVAL MANNSCHRECK

Scout

KANSAS

Map No. 46 Sec. 36 Twp. 19 R. 11Well No. 4 RiserContinental Company

Contractor

SECTION PLAT

Ft. from N. Line

330 Ft. from S. Line990 Ft. from E. Line

Ft. from W. Line

COMPLETE

Location

Rig up

Drilling and Remarks:

Top Sil 32782000 acid1585 7/8

RECORD

Cased _____ in., _____ ft.

Sand _____

Gas _____

Oil _____

Total Depth 3290

PRODUCTION

1st 24 hrs. Nat. _____

1st 24 hrs. after shot _____

Gas _____ Cu. Ft.

Dry Hole _____

Abandoned _____

Date

3/25/36 192

S. J. LEWIS Scout