


Map No. **KANSAS** Sec. **36** Twp. **19** R. **11W**Well No. **3-Riser** Farm
Continental Company

NORTH

WEST

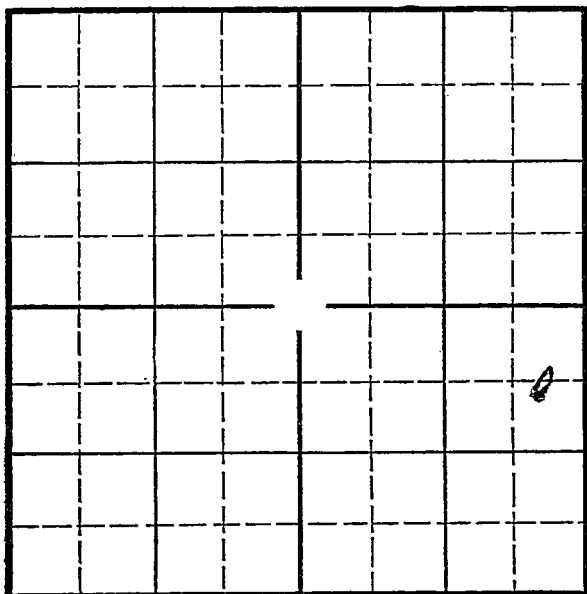

EAST

SOUTH

Location _____

Drilling Remarks _____

RECORD

Cased _____ in. _____ ft.

Sand _____

Gas _____

Oil _____

Total Depth _____

Rig Up _____

Drilling Remarks _____

PRODUCTION

1st 24 hrs. Nat. _____

1st 24 hrs. after shot _____

Gas _____ cu. ft. _____

Dry Hole _____

Abandoned _____

Map No. KANSAS

Sec. 36

Twp. 19 R. 11W

Well No. 3- Risse Farm

Continental Company


660 Ft. from N. Line

 Ft. from S. Line

330 Ft. from E. Line

 Ft. from W. Line

Elev. 1763

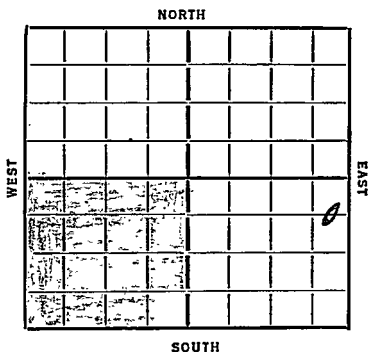

REPORT

1936
2/5 Cells
2/14 Test on Pump
2/21 BR
2/28 Blg 537 12" 176
3/4 " 2200
3/13 " 2990
3/20 T. Sil 3264 7"-3267 T.D. RUST.
3/27 Swabbing 57 bbls per hr.
4/2 --
4/1 Sil 3264
T.D 3267
1555 Bbls.

COMPLETED

Map No. 46 Sec. 36 Twp. 19 R. 11WWell No. 3-RisseContinental Company

Contractor

C E L N E S E


SECTION PLAT

660 Ft. from N. Line

Ft. from S. Line

330 Ft. from E. Line

Ft. from W. Line

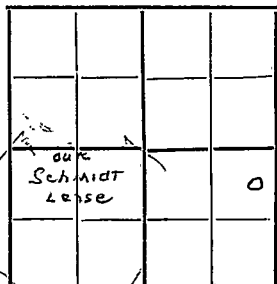

FIRST REPORT

Location.....

Rig up.....

Drilling and Remarks:

Cellar

RECORD

Cased.....in.,ft.

Sand.....

Gas.....

Oil.....

Total Depth.....

PRODUCTION

1st 24 hrs. Nat.....

1st 24 hrs. after shot.....

Gas.....Cu. Ft.

Dry Hole.....

Abandoned.....

Date

FEB 5 1936

ORVAL MANNSCHRECK

192.....Scout

Map No. 46 Sec. 36 Twp. 19 R. 11W
 Well No. 3-Rise

Continental oil

Company

Contractor

COMPLETE

SECTION PLAT

660 Ft. from N. Line

..... Ft. from S. Line

330 Ft. from E. Line

..... Ft. from W. Line

			0

Location.....

Rig up.....

Drilling and Remarks:

1555 f/b

RECORD

Cased..... in. ft.

Sand Sil 3264

Gas.....

Oil.....

Total Depth 3267

PRODUCTION

1st 24 hrs. Nat.....

1st 24 hrs. after shot.....

Gas..... Cu. Ft.

Dry Hole.....

Abandoned.....

ORVAL MANNSCHRECK

Date

4-1-36 192..... Scout