

Barton

Map No. KANSAS Sec. 36 Twp. 19 R. 11W

Well No. 2- Risse Farm _____
Continental Oil Company _____


_____ Ft. from N. Line

330 Ft. from S. Line

_____ Ft. from E. Line

330 Ft. from W. Line

Elev. 1762

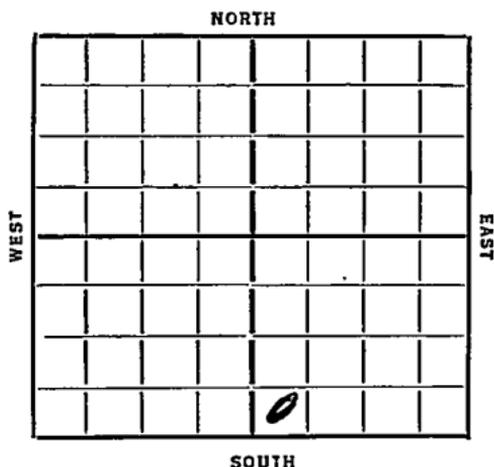

REPORT

~~1936~~
1/29 Bldg Rig
2/7 Rig
2/14 Bldg 609
2/21 " 2795
2/28 Lams. 2990 T Sil 3278
TD 328 of WOC
3/5 Top Siliceous 3278
TD 3289 - 3100' Oil
Swabbed 419 Bbls Oil in
8 hrs
Acidized 1000 Gal acid (2d)
3/9 Potential 1919 Bbls Oil (2d)
3/1 Sil 3278
TD 3289
Swab 419 Bbls Oil 8 hrs.
1000 acid
1919 Bbls.

COMPLETED

Map No. 46 Sec. 36 Twp. 19 R. 11W

Well No. 2-Kisse

Continental Oil Company

Contractor

FIRST REPORTS

..... Ft. from N. Line

330 Ft. from S. Line

..... Ft. from E. Line

330 Ft. from W. Line

SECTION PLAT

		0	

Location.....

Rig up.....

Drilling and Remarks:

Bldg Rig

RECORD

Cased..... in., ft.

Sand.....

Gas.....

Oil.....

Total Depth.....

PRODUCTION

1st 24 hrs. Nat.....

1st 24 hrs. after shot.....

Gas..... Cu. Ft.

Dry Hole.....

Abandoned.....

Date

1-29-36 192.....

ORVAL MANNSCHRECK

Scout

Map No. 46 Sec. 36 Twp. 19 R. 11W

Well No. 2-Risse

Continental oil Company

Contractor

COMPLETE

SECTION PLAT

..... Ft. from N. Line

330 Ft. from S. Line

..... Ft. from E. Line

330 Ft. from W. Line

Offset

Location.....

Rig up.....

Drilling and Remarks:

swab 419 bbls
8 hrs.
1000 acid
1919 bbls

RECORD

Cased..... in., ft.

Sand oil 3278

Gas.....

Oil.....

Total Depth. 3289

PRODUCTION

1st 24 hrs. Nat.....

1st 24 hrs. after shot.....

Gas..... Cu. Ft.

Dry Hole.....

Abandoned.....

Date

3-11-36 192

ORVAL MANNSCHRECK

Scout