

Barton

Form 51—5M—3-35—Mid-West

Map No. _____ Sec. 36 Twp. 19 R. 11-W

Well No. #4-Schmidt Farm
Texas Oil Company

NORTH


Location _____

Drilling Remarks

Rig Up

Drilling Remarks

RECORD

Cased _____ in. _____ ft.

Sand

Gas

Oil

Total Depth _____

PRODUCTION

1st 24 hrs. Nat. _____

1st 24 hrs. after shot-----

Gas_____cu. ft._____

Dry Hole_____

Abandoned_____

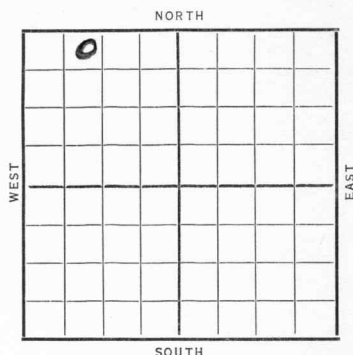
KANSAS

Form 252-A—5M—7-36—Palace

Barton

Sec. 36 Twp. 19 R. 11-WWell No. #4-Schmidt FarmTexas Oil Company330 Ft. from N. Line Ft. from S. Line Ft. from E. Line990 Ft. from W. Line

Elev. 1767

Date
1936

REPORT

9/16 Rig

9/24 12" @ 152'. Drlg. 600'.

10/1 Drlg. 2670'.

10/8 Sil. 3286'. T.D. 3291'. RUST.

10/15--

10/21/36-Sil. 3286'.

T.D. 3293'.

Potential 1830 bbls of oil.

COMPLETED

KANSAS

Map No. 46 Sec. 36 Twp. 19 R. 11WWell No. 4 SchmittTexas Oil Company

Contractor

SECTION PLAT

0			

330 Ft. from N. Line

_____ Ft. from S. Line

_____ Ft. from E. Line

990 Ft. from W. Line

FIRST REPORT

Location _____

Rig up _____

Drilling and Remarks:

Rig

RECORD

Cased _____ in., _____ ft.

Sand _____

Gas _____

Oil _____

Total Depth _____

PRODUCTION

1st 24 hrs. Nat. _____

1st 24 hrs. after shot _____

Gas _____ Cu. Ft.

Dry Hole _____

Abandoned _____

Date

SEP 16 1936

19

S. J. LEWIS

Scout

Map No. 46 Sec. 36 Twp. 19 R. 11W

Well No. 4 Schmidt

Texas Company

Contractor

SECTION PLAT

0			

330 Ft. from N. Line

_____ Ft. from S. Line

_____ Ft. from E. Line

990 Ft. from W. Line

COMPLETED

Location _____

Rig up _____

Drilling and Remarks:

Sil 3286

Po Ventura
1530

RECORD

Cased _____ in., _____ ft.

Sand _____

Gas _____

Oil _____

Total Depth 3299

PRODUCTION

1st 24 hrs. Nat. _____

1st 24 hrs. after shot _____

Gas _____ Cu. Ft.

Dry Hole _____

Abandoned _____

Date

OCT 21 1936 19

S. J. LEWIS Scout