

## Form 51-5M-3-35-Mid-West

NORTH

WEST

## FEAST

**SOUTH**

### Drilling Remarks

### Drilling Remarks

## RECORD

Sand

Gas..... 44

# Oil

Total Depth\_\_\_\_\_

## PRODUCTION

1st 24 hrs. after shot\_\_\_\_\_

Gas.....cu. ft.

Dry Hole\_\_\_\_\_

Abandoned\_\_\_\_\_


*Barton*  
Map No.            Sec. 36 Twp. 19 R. 11W  
Well No. 5 *F. J. Wendel* Farm  
*Gulch Oil* Company

1155 Ft. from N. Line

           Ft. from S. Line

990 Ft. from E. Line

           Ft. from W. Line

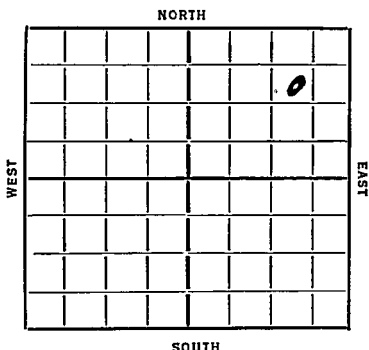

REPORT

*1936*  
*3/18* *Bldg Rot Rig*  
*3/20* --  
*3/27* 15"-157 Drlg. 1650'  
*4/2* Drlg. 2023'  
*4/10* Sil. 3274' Set 7"@ 3275' T.D. 3279  
Bailing.  
*4/16* T.D. 3283'- 670 bbls oil 16 hours.  
*4/22/36*- Sil. 3274'  
T.D. 3283'  
1000 acid. ---\* 189 bbls nat.  
1121 bbls. Potential.

COMPLETED

*Barton*  
 Map No. 46 Sec. 36 Twp. 19 R. 11W

Well No. 5-F. J. Wendel

Gulf Oil Company

Contractor

## FIRST REPORT

## SECTION PLAT

1155 Ft. from N. Line

\_\_\_\_\_ Ft. from S. Line

990 Ft. from E. Line

\_\_\_\_\_ Ft. from W. Line

|  |  |  |   |
|--|--|--|---|
|  |  |  | 0 |
|  |  |  |   |
|  |  |  |   |
|  |  |  |   |
|  |  |  |   |

Location \_\_\_\_\_

Rig up \_\_\_\_\_

Drilling and Remarks:

*Bedg Rot.*  
*129*

## RECORD

Cased \_\_\_\_\_ in., \_\_\_\_\_ ft.

Sand \_\_\_\_\_

Gas \_\_\_\_\_

Oil \_\_\_\_\_

Total Depth \_\_\_\_\_

## PRODUCTION

1st 24 hrs. Nat. \_\_\_\_\_

1st 24 hrs. after shot \_\_\_\_\_

Gas \_\_\_\_\_ Cu. Ft.

Dry Hole \_\_\_\_\_

Abandoned \_\_\_\_\_

Date

3-18-36 192

**ORVAL MANNSCHRECK**  
 Scout

KANSAS

Map No. 46 Sec. 36 Twp. 19 R. 11 W.Well No. 5 F. J. WendelGulf. Company

Contractor

## SECTION PLAT

|  |  |  |   |
|--|--|--|---|
|  |  |  |   |
|  |  |  | 0 |
|  |  |  |   |
|  |  |  |   |
|  |  |  |   |
|  |  |  |   |

1153 Ft. from N. Line

..... Ft. from S. Line

990 Ft. from E. Line

..... Ft. from W. Line

COMPLETED

Location.....

Rig up.....

Drilling and Remarks:

Sil 3274  
1898 1/2 Nat.  
1000 acid

1121 1/2 Pot.  
1121 1/2 Pot.

## RECORD

Cased..... in., ..... ft.

Sand.....

Gas.....

Oil.....

Total Depth 3283

## PRODUCTION

1st 24 hrs. Nat.....

1st 24 hrs. after shot.....

..... Cu. Ft.

Dry Hole.....

Abandoned.....

Date

APR 22 1936

192.....

S. J. LEWIS

Scout