

Farm

Company

NORTH

WEST

EAST

SOUTH

Location

Drilling Remarks

Rig Up.

Drilling Remarks

RECORD

Cased _____ in. _____ ft.

Sand.

Gas

Oil.

Total Depth

PRODUCTION

1st 24 hrs. Nat.

1st 24 hrs. after shot

Gas_____cu. ft.

Dry Hole

Abandoned

Map No. KANSAS Sec. 36 Twp. 19 R. 11W
Well No. 1 - Schmidt Farm
Mid - Continent Pet. Corp. Company


Ft. from N. Line

330 Ft. from S. Line

330 Ft. from E. Line

Ft. from W. Line

Elevation 1763

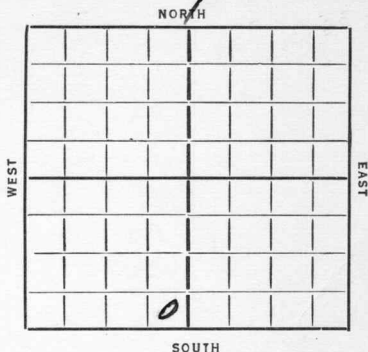

Date 1935 REPORT Elev. 1763

12/18 Dig Cellar

12/26 Rig & M. I. Tools

12/30 T.D. 100 feet

fighting cave (Tel)

1/1/36 Telg 1100 (Tel)

1/2 " 1550 (Tel)

1/3 " 2000 (Tel)

1/7 " 2935 (Tel)

1/9 " 3215 (Tel)

Will take a core this afternoon (Tel)

1/10 Top Siliceous lime 3276

T.D. 3281 (Core 3273-81 Rec Sat Core)

Last 3 feet showed nice

saturated lime (Tel)

1/15 Start bailing today

Drill in about Friday (Tel)

1/18 Drilled cement

Filled up 1600 feet oil in

40 Minutes

Connecting up (Tel)

OVER

1936

1/19 Top Silicious 3276
FD 3286
Hole full Oil in 2 hrs &
15 Minutes
Will swab (Tel)

1/20 Swabbed 58 to 60 Bbls
per hr last 8 hrs
1000 feet off Bottom
Rung rods & tubing (Tel)

1/22 - Taking potential

1st hour	78 ⁴⁰	barrels oil
"	72 ⁸⁰	
"	67 ²⁰	
"	78 ⁴⁰	
"	78 ⁴⁰	
"	78 ⁴⁰	
"	74 ⁴⁰	
"	67 ²⁰	
"	72 ⁸⁰	
"	78 ⁴⁰	
"	72 ⁸⁰	
"	72 ⁸⁰	
"	72 ⁸⁰	
"	67 ²⁰	
"	72 ⁸⁰	

1st 15 hrs made 1097 bbls

1/22 Potential gauge 1676 Bbls
Oil Natural (Tel)

OVER

Map No. _____ Sec. _____ Twp. _____ R. _____

Well No. _____ Farm _____


_____ Company _____

_____ Ft. from N. Line

_____ Ft. from S. Line

_____ Ft. from E. Line

_____ Ft. from W. Line

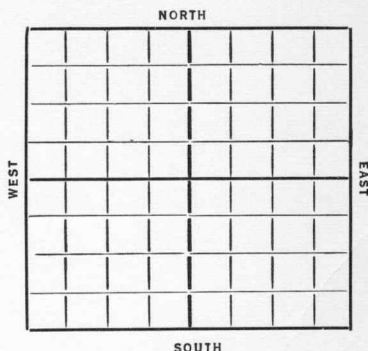

REPORT

Date 1/29/36

Oil 3276
TD 3286
1676 Bbls Natural

COMPLETED

3/5 Acidized 1000 Gal acid
(Reason we acidized is that the offset was acidized) (Tel)
3/9 Potential 2034 Bbls Oil after acidizing (Tel)
5/7 60 day retest 2155 Bbls (Tel)
10/20/36 Retest 2284 Bbls 24 hrs.
(Based on 6 hr test of 571 Bbls) (Tel)
10/4/37 - New potential 1523 Bbls (Tel)

KANSAS

Map No. 46 Sec. 36 Twp. 19 R. 11 WWell No. 1-Schmidt
Mid Cont. Pet Company

Contractor

COMPLETE

SECTION PLAT

Ft. from N. Line

330 Ft. from S. Line330 Ft. from E. Line

Ft. from W. Line

Location

Rig up

Drilling and Remarks:

1676 bbls
Natural

RECORD

Cased in., ft.Sand Sil 3276

Gas

Oil

Total Depth 3286

PRODUCTION

1st 24 hrs. Nat.

1st 24 hrs. after shot

Gas Cu. Ft.

Dry Hole

Abandoned


Date

ORVAL MANNSCHRECK

1-29-36 192

Scout

no trace

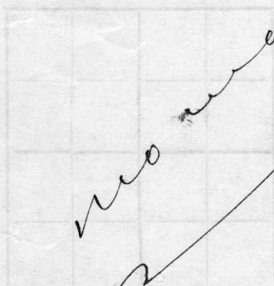

Ft. from N. line
 Ft. from S. line
 Ft. from E. line
 Ft. from W. line

RECORD

Returned	<i>[Signature]</i>
Cards	<i>[Signature]</i>
Tracing	<i>[Signature]</i>
France Map	<i>[Signature]</i>
Scarborough Map	<i>[Signature]</i>
Moody Map	<i>[Signature]</i>
Scarborough Plat Book	<i>[Signature]</i>
Moody Plat Book	<i>[Signature]</i>

Map No. 46 Sec. 36 Twp. 19 R. 11^W

Well No. 1-Schmidt

Mid-Cont. Pet. Company

Contractor

FIRST REPORTS

SECTION PLAT

.....Ft. from N. Line

330 Ft. from S. Line

330 Ft. from E. Line

.....Ft. from W. Line

Location ☒

Rig up

Drilling and Remarks:

Dig cellar

RECORD

Cased.....in.,ft.

Sand.....

Gas.....

Oil.....

Total Depth.....

PRODUCTION

1st 24 hrs. Nat.....

1st 24 hrs. after shot.....

Gas.....Cu. Ft.

Dry Hole.....


Abandoned.....

Date

12-18-35 192.....

ORVAL MANN-SCHRIECK

Scout

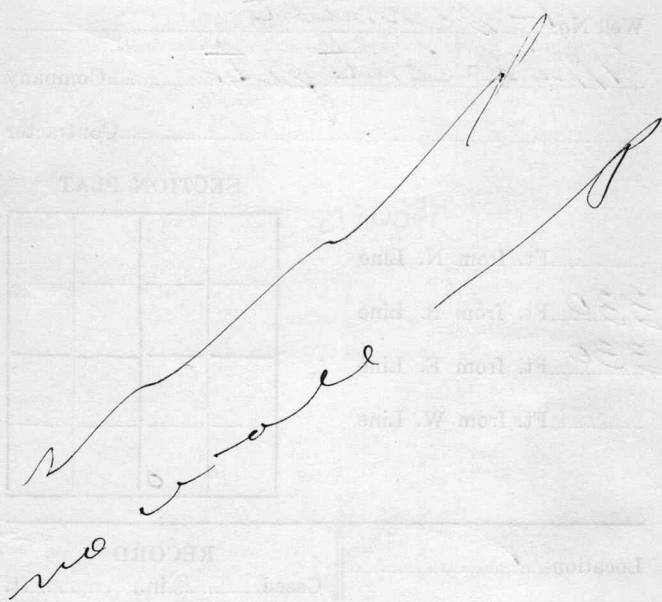

Returned	✓
Cards	✓
Tracing	✓
France Map	✓
Scarborough Map	✓
Moody Map	✓
Scarborough Plat Book	✓
Moody Plat Book	✓

Date