


DRILLING WELL COMPLETION REPORT

Well No. ONE (1) Farm Name CARL SCHMIDT
Date drilling completed Jan. 23, 1936
Description SW $\frac{1}{4}$ Sec. 36-19S-11W
County Barton, State Kansas
Initial production 1676 bbls. Total depth 3286 feet
Initial volume _____ cu. ft. _____ lbs. rock pressure
Pipe Line Company _____
Gas Company _____
Remarks: _____

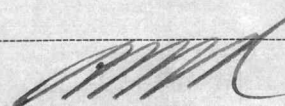


Accounting Dept.
Rental Dept.
Scouting Dept. ✓
Engineering Dept.
Legal Dept.
Lease Inventory Man
Tax Dept.
Geological
File

LOCATION NOTICE

TULSA, OKLA., January 20, 1936 193.WELL NO. Two (2) ON Carl Schmidt FARM

WILL BE AS FOLLOWS:

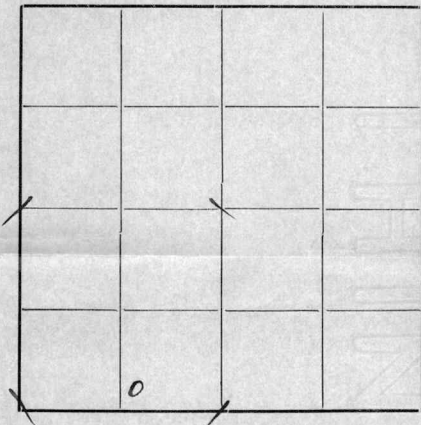

..... FEET FROM NORTH LINE

990 FEET FROM EAST LINE330 FEET FROM SOUTH LINE

..... FEET FROM WEST LINE

IN SW¹ SEC. 36 TWP. 19S RANGE 11WBarton COUNTY, STATE OF Kansas

REMARKS:

.....

.....

.....

COPIES TO

SIGNED [Signature]

DISTRICT SUPT.
 ACCOUNTING DEPT.
 RENTAL DEPT.
 SCOUTING DEPT.
 ENGINEERING DEPT.
 LEGAL DEPT.
 CLAIM DEPT.
 TAX DEPT.
 GEOLOGICAL DEPT.
 FILE
 LEASE INVENTORY

One (1) Carl Schmidt
WELL NO. _____ ON _____ FARM _____

----- FEET FROM NORTH LINE
 330 ----- FEET FROM EAST LINE
 330 ----- FEET FROM SOUTH LINE
 ----- FEET FROM WEST LINE

 SW 1/4 SEC. 36 TWP. 19S RANGE 11W
 Barton COUNTY, STATE OF Kansas

REMARKS:

COPIES TO _____ SIGNED _____

DISTRICT SUPT.
ACCOUNTING DEPT.
RENTAL DEPT.
SCOUTING DEPT. ✓
ENGINEERING DEPT.
LEGAL DEPT.
CLAIM DEPT.
TAX DEPT.
GEOLOGICAL DEPT.
FILE
LEASE INVENTORY

$$\begin{array}{r} 2391 \\ 574 \overline{) 12954} \\ \underline{1158} \\ 1374 \\ \underline{1374} \\ 0 \end{array}$$