

Rice

# KANSAS

FORM 51 25M 3/49 PETROL

Section 36 Township 19S Range 10W

Well No. #1 Kropf

Company Birmingham & Bartlett

NORTH

0									

WEST

EAST

SOUTH

Rice ✓

Sec. 36 Twp. 19 R. 10-W

Well No. #1 Kropp Farm

Birmingham & Bartlett Company

Silica


\_\_\_\_\_ Ft. from N. Line

330 Ft. from S. Line

\_\_\_\_\_ Ft. from E. Line

330 Ft. from W. Line

SW NW

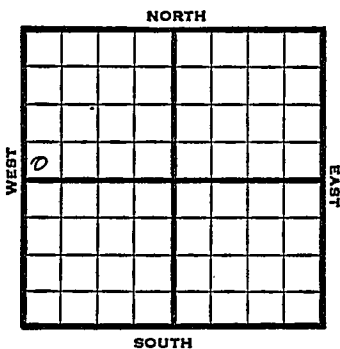

1949

Elev. 1734' \_ R E P O R T

10/12

Surface hole

10/19

8" @ 185'  
Drlg 2630'

10/26

Lans 2959'  
Arb 3293'  
TD 3303'

**ABANDONED**

Map No. \_\_\_\_\_ Sec. 36 Twp. 19 R. \_\_\_\_\_

Well No. 1 Kropf

Birmingham & Bartlett Company

Contractor

SW NW

FIRST REPORT  
SECTION PLAT

\_\_\_\_\_ Ft. from N. Line

330 Ft. from S. Line

\_\_\_\_\_ Ft. from E. Line

330 Ft. from W. Line


Rice County

Location \_\_\_\_\_

Rig up \_\_\_\_\_

Drilling and Remarks:

surface hole

RECORD

Cased \_\_\_\_\_ in., \_\_\_\_\_ ft.

Sand \_\_\_\_\_

Gas \_\_\_\_\_

Oil \_\_\_\_\_

Total Depth \_\_\_\_\_

PRODUCTION

1st 24 hrs. Nat. \_\_\_\_\_

1st 24 hrs. after shot \_\_\_\_\_

Gas \_\_\_\_\_ Cu. Ft.

Dry Hole \_\_\_\_\_

Abandoned \_\_\_\_\_

Date

OCT 12 1949

19

S. I. LEWIS

Scout

Scout Cards	.....
Land Small Map	.....
Land Wall Map	.....
Tracings	.....
France Map	.....
Pierce Map	.....
Misc.	.....

*Earth*

Kansas

Silica Pool

Map No. \_\_\_\_\_ Sec. 36 Twp. 19 R. 10WWell No. 1 Kropf

Birmingham &amp; Bartlett Company

ABANDONED

Contractor


SW NW

*E1,1734*  
SECTION PLAT

\_\_\_\_\_ Ft. from N. Line

330 Ft. from S. Line

\_\_\_\_\_ Ft. from E. Line

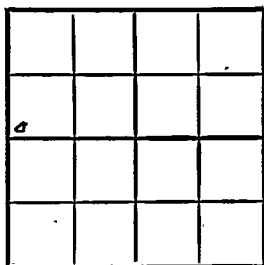330 Ft. from W. Line

Rice County

Location \_\_\_\_\_

Rig up \_\_\_\_\_

Drilling and Remarks:

*Log 2959**Ord 3292*

## RECORD

Cased \_\_\_\_\_ in., \_\_\_\_\_ ft.

Sand \_\_\_\_\_

Gas \_\_\_\_\_

Oil \_\_\_\_\_

Total Depth 2312

## PRODUCTION

1st 24 hrs. Nat. \_\_\_\_\_

1st 24 hrs. after shot \_\_\_\_\_

Gas \_\_\_\_\_ Cu. Ft.

Dry Hole \_\_\_\_\_

Abandoned \_\_\_\_\_

Date

OCT 26 1949 19

S. J. LEWIS

Scout

Scout Cards .....  
Land Small Map .....  
Land Wall Map .....  
Tracings .....  
France **OCT 28 1919** .....  
Pierce M. O .....  
Misc. ....