

# KANSAS


FORM 51 5M 1-42 PETROL

Rice

Section 36 Township 19 Range 10-W

Well No. #2 Kropf

Company Phillips

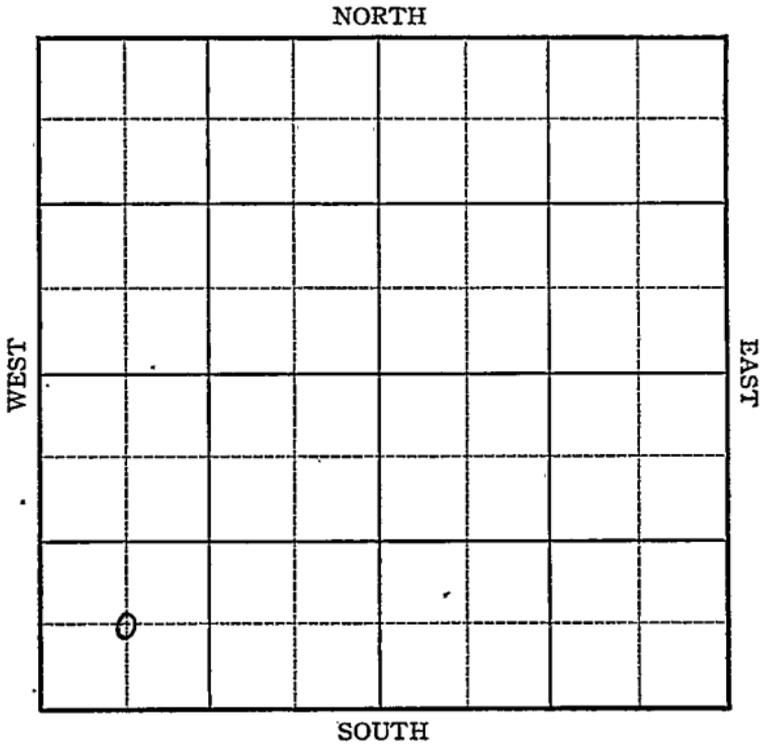

**KANSAS**

Rice

Sec. 36 Twp. 19 R. 10-W

Well No. #2 Kropf Farm

Phillips Company


\_\_\_\_\_ Ft. from N. Line

660 Ft. from S. Line

\_\_\_\_\_ Ft. from E. Line

660 Ft. from W. Line

Silica Pool

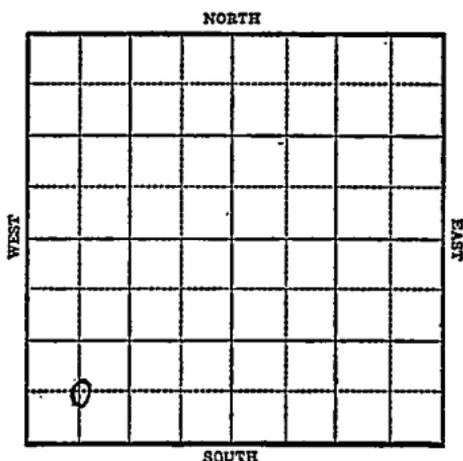

1943

*Weld, 1937* R E P O R T

7/28 Location

8/4 Drlg. 2952'

8/11 Lans 2974

Arb 3296

Drlg. 3555'

8/18 " "

8/25 Arb 3296'

T.D. 3555'

**ABANDONED**

Rice

**KANSAS**Map No. 46 Sec. 36 Twp. 19 R. 10WWell No. 2 KropfPhillips CompanyFIRST REPORT Contractor

C SW SW

\_\_\_\_\_ Ft. from N. Line

660 Ft. from S. Line

\_\_\_\_\_ Ft. from E. Line

660 Ft. from W. Line

## SECTION PLAT

Q			

## SILICA POOL

Location XXXX

Rig up \_\_\_\_\_

Drilling and Remarks:

## RECORD

Cased \_\_\_\_\_ in., \_\_\_\_\_ ft.

Sand \_\_\_\_\_

Gas \_\_\_\_\_

Oil \_\_\_\_\_

Total Depth \_\_\_\_\_

## PRODUCTION

1st 24 hrs. Nat. \_\_\_\_\_

1st 24 hrs. after shot \_\_\_\_\_

Gas \_\_\_\_\_ Cu. Ft.

Dry Hole \_\_\_\_\_

Abandoned \_\_\_\_\_

Date

JUL 2 8 1943 19S. J. LEWIS Scout

Misc. Small Maps

Cards

Tracing

France Map

Scarborough Map

Moody Map

Geological Dept.

Moody Plat Book

*Original*

*See to*

*M.L.*

*M.S.*

*M.S.*

*M.S.*

**KANSAS**  
 Map No. 46 Sec. 36 Twp. 19 R. 10W

Well No. 2 Kropf

Phillips Company

ABANDONED Contractor

**C SW SW**  
 Ft. from N. Line

660 Ft. from S. Line

Ft. from E. Line

660 Ft. from W. Line

**SECTION PLAT**

o			

**Silica Pool**

Location \_\_\_\_\_

Rig up \_\_\_\_\_

Drilling and Remarks:

*See 73296*

**RECORD**

Cased \_\_\_\_\_ in., \_\_\_\_\_ ft.

Sand \_\_\_\_\_

Gas \_\_\_\_\_

Oil \_\_\_\_\_

Total Depth 3555

**PRODUCTION**

1st 24 hrs. Nat. \_\_\_\_\_

1st 24 hrs. after shot \_\_\_\_\_

Gas \_\_\_\_\_ Cu. Ft.


Dry Hole \_\_\_\_\_

Abandoned \_\_\_\_\_

Date

**AUG 25 1943** 19

**S. J. LEWIS** Scout

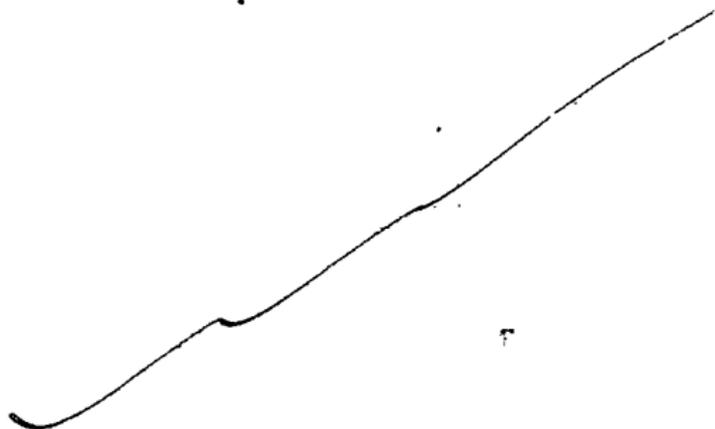

Misc. Small Maps	<i>Osma</i>
Cards	<i>Madge</i>
Tracing	<i>M.E.P.</i>
France Map	<i>[checkmark]</i>
Scarborough Map	<i>[checkmark]</i>
Moody Map	<i>M.E.P.</i>
Geological P. r.	
Moody P. r. Feet	