


Section 36 Township 19 Range 10W

Well No. #3 Kropf. (A)

Company W. L. Hartman

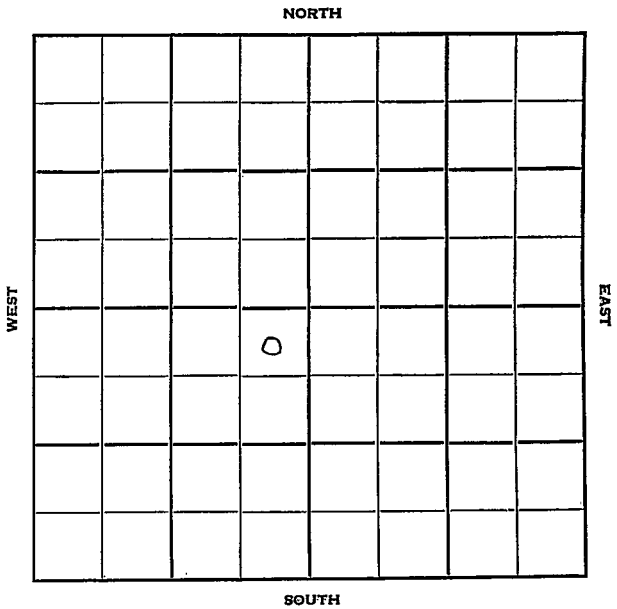

Rice

KANSAS

Sec. 36 Twp. 19 R. 10 W

Well No. # 3 Kropf. (A) Farm

W. L. Hartman Company

B & B Contractor

Silicia


330 Ft. from N. Line

_____ Ft. from S. Line

330 Ft. from E. Line

_____ Ft. from W. Line

NE NE SW

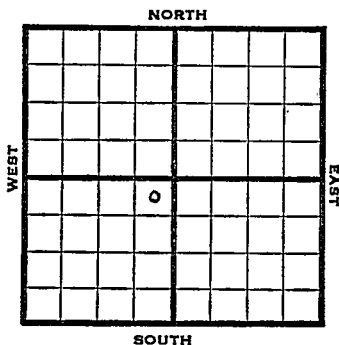

1951

Elev. 1730' REPORT

10/17

Spud 10-13-51
8" @ 190'
Drilling 1950'

11/7

Spud 10-13-51
Oil Well TD 3266
8" @ 190
Top 2534 Heeb. 2807
Br Lime 2933 Lans. 2957
DST 3038-50 opn 1 hr.
Rec.15' mud DST 3136-52 opn 1 hr.
Rec.15' mud BKG 3220
Arb. 3265 TD 3266
5" @ 3264 CO to 3266
1000 A Comp. 50 bopd

COMPLETED

1.

Operator W. L. Hartman

Well No. 3 Farm Kropf. (A)

Elev.	Location	NE	NE	SW

FIRST ~~REF UNIT~~

330 Ft. From N Line SW

530 Ft. From E Line Quarter

Ist. Report OCT 17 1951

Completion _____

Remarks

B & B - Contr.

Spudding Date **10-13-51**

Drlg. Data Silicia

8ⁿ @ 190 Drlg. 1950

J. E. TYRA

County Rice State Kansas

Sec. 36 (Blk. Twp.) 19 (Sur. Rge.) 10W Map No.

Operator W. L. Hartman

Well No. 3 Farm Kropf "A"

Elev.	1730	Location	NE NE SW
-------	------	----------	----------

COMPLETE

330 Ft. From N Line SW

330 Ft. From H Line Quarter

Ist. Report

Completion NOV 7 1951

Remarks Silica Pool

B & B Drlg. - Contr.

Spudding Date 10-13-51

Drilg. Data Oil well TD 3266

8" @ 190 Top. 2534 Heeb. 2807

Br. lime 2933 Lans. 2957 DST 3038-50

open 1 hr. Rec. 15' mud DST 3136-52

open, 1 hr. Rec. 15' mud B KC 3220

Arb. 3265 TD.3266 5" @ 3264 CO to 3266

1000 A. Comp. 50 bopd

J. E. TYRA