


Section 36 - Township 19 Range 10W

Well No. h. Kropf "A"

Company W. L. Hartman

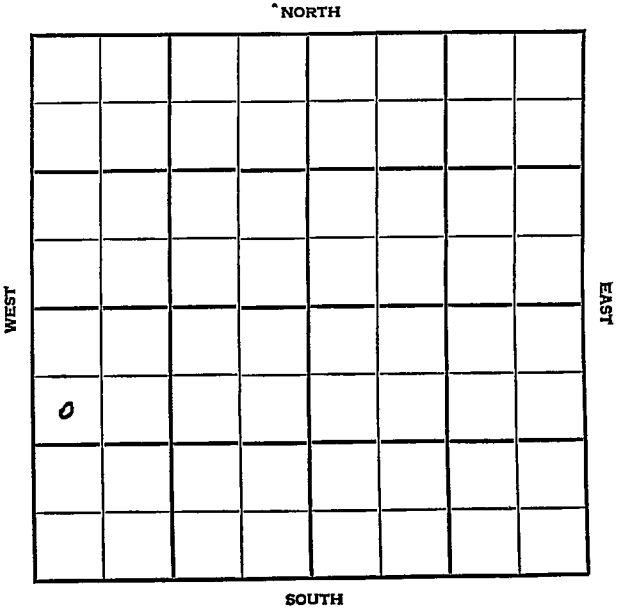

Rice

KANSAS

SEC.	TWP.	R.
36	19	LOW


WELL NO. #4 Kropf "A" FARM

COMPANY W. L. Hartman

CONTRACTOR Hartman

Chase-Silica Pool

Ft. from N. Line
 1620 Ft. from S. Line
 Ft. from E. Line
 330 Ft. from W. Line

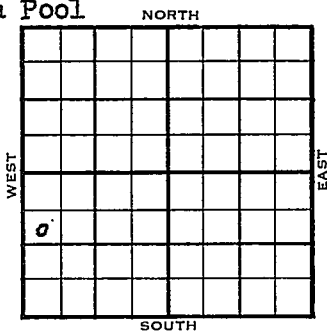

SW NW SW

1954	ELEVATION 1735'	REPORT
------	--------------------	--------

5/26

Spud 5-19-54
 8" @ 191'
 Drlg 2746'

6/2

Spud 5-19-54 D & A TD 3323
 8" @ 191' Top. 2542 Heeb 2814
 B. Oread 2845 Br line 2940
 Lans 2961 B KC 3224 Simp 3266
 Arb. 3277 TD 3323 D & A

ABANDONED

County Rice State KansasSec. 36 (Bk.
Twp.) 19 (Sur.
Rge.) 10W Map No.Operator W. L. HartmanWell No. 4 Farm Kropf "A"Elev. 1735 Location SW NW SW

0					

1620 Ft. From S Line SW300 Ft. From W Line Quarter

1st. Report

Completion JUN 2 1954Remarks Chase-Silica PoolHartman - Contr.Spudding Date 5-19-54Drlg. Data D & A TD 33238" @ 191 Top. 2542 Heeb. 2814B. Oread 2845 Br. lime 2940Lans. 2961 B KC 3224 Simp. 3266Arb. 3277 TD 3323D & A