


Section 36 Township 19 Range 10W

Well No. 1 C. C. Busch

Company W. L. Hartman

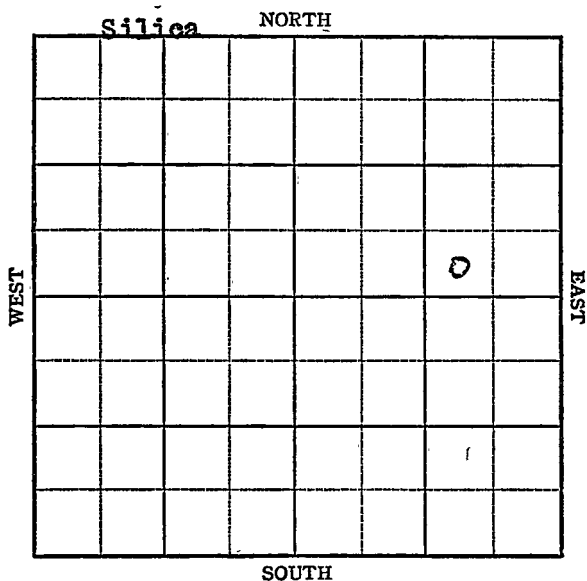

KANSAS

Rice

19

10W

Sec. 36 Twp. _____ R. _____Well No. #1 C.C. Busch Farm _____

W.L. Hartman Company


Silica

Ft. from N. Line

330 Ft. from S. Line990 Ft. from E. Line

Ft. from W. Line

SW SE NE

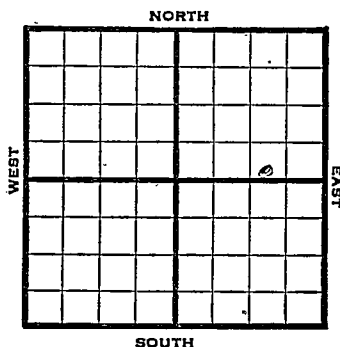

1947

REPORT

9/10	8-5/8" @ 200 WOC
9/17	Drilg. 2765'
9:24	Lansing 2953' Simpson 3260' TD 3262' 5" @ 3261' RUST
10/1	"
10/8	"
10/15	2800' oil in 12 hrs.
10/22	"
10/29	"
11/5	"
11/12	Pump 8 bbls. oil PH
11/19	"
11/25	"
12/3	"
12/10	"

OVER

1947

12/17 Simpson 3260'
5" @ 3261'
Pump 50 Pot
TD 3262'
Gravity 43

COMPLETED

Map No. _____ Sec. 36 Twp. 19 R. 10W

Well No. 1 C. C. Busch

W. L. Hartman Company

FIRST REPORT

Contractor

SW SE NE


SECTION PLAT

_____ Ft. from N. Line

330 Ft. from S. Line

990 Ft. from E. Line

_____ Ft. from W. Line

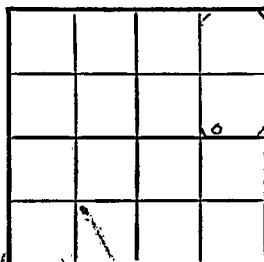

Rice County

Location _____

Rig up _____

Drilling and Remarks:

8 5/8" @ 200

WOC

RECORD

Cased _____ in., _____ ft.

Sand _____

Gas _____

Oil _____

Total Depth _____

PRODUCTION

1st 24 hrs. Nat. _____

1st 24 hrs. after shot _____

Gas _____ Cu. Ft.

Dry Hole _____

Abandoned _____

Date

SEP 10 1947

19

S. J. LEWIS

Scout

Wm

Misc. Small Maps	_____
Cards	<i>EN</i>
Tracing	_____
France Map	_____
Scarborough Map	_____
Fierce Map	_____
Ceological Dept.	_____
Pierce Plat Book	_____

Map No. 46 Sec. 36 Twp. 19 R. 10W

Well No. 1 C. C. Busch

W. L. Hartman Company

COMPLETE

Contractor

SW SE NE


E1172?
SECTION PLAT

 Ft. from N. Line

330 Ft. from S. Line

990 Ft. from E. Line

 Ft. from W. Line

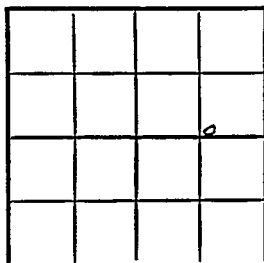

Rice County

Location

Rig up

Drilling and Remarks:

Sing 3260

5" @ 261

Pump 50 BX

413 0/4

RECORD

Cased in., ft.

Sand

Gas

Oil

Total Depth 3262

PRODUCTION

1st 24 hrs. Nat.

1st 24 hrs. after shot

Gas Cu. Ft.

Dry Hole

Abandoned

Date

DEC 17 1947

19

S. J. LEWIS

Scout

[Handwritten signature]

Misc. Small Maps	<i>[initials]</i>
Cards	<i>Elaine</i>
Tracing	<i>[initials]</i>
France Map	<i>[initials]</i>
Scarborough Map	<i>[initials]</i>
Pierce Map	<i>[initials]</i>
Pierce Plat Book	