


Section 36 Township 19 Range 10 W

Well No. # 2 Kropf "A"

Company W. L. Hartman

NORTH

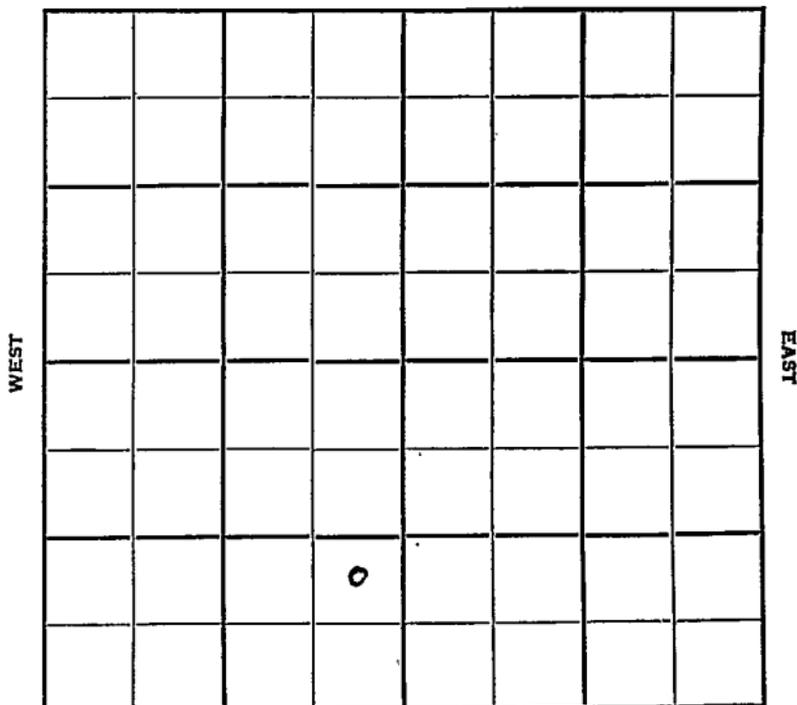

SOUTH

Rice

KANSAS

Sec. 36 Twp. 19 R. 10 W ✓

Well No. # 2 Kropf "A" Farm

W. L. Hartman Company

Contractor


Ft. from N. Line

990 Ft. from S. Line

330 Ft. from E. Line

Ft. from W. Line

NE SE SW

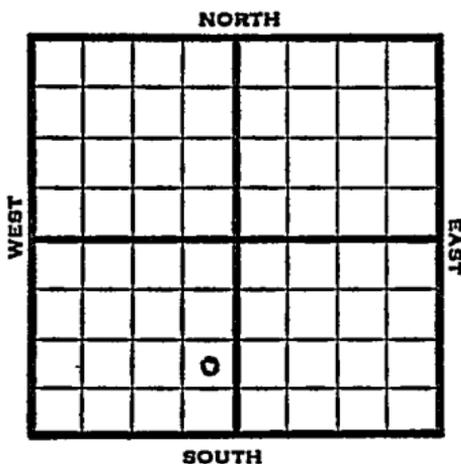

1951 Elev. 1734 REPORT

2/14 Location
5/16 Abandoned location

ABANDONED

