


Section 36 Township 19 Range 10 WWell No. # 7 LinkeCompany W. L. Hartman

NORTH

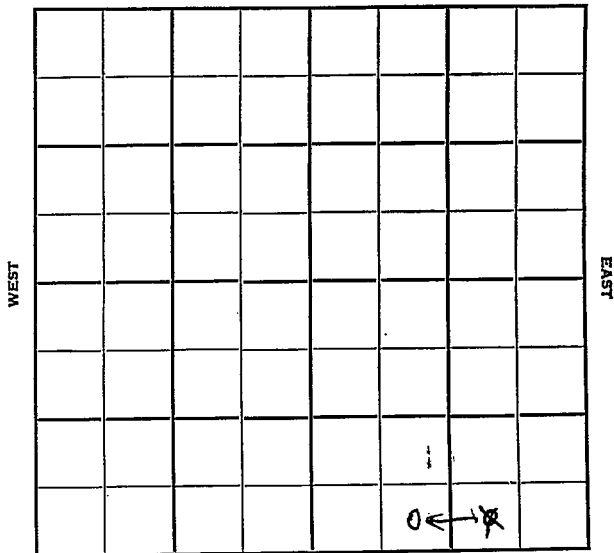

Rice

KANSAS

Sec. 36 Twp. 19 R. 10 W ✓

Well No. # 7 Linke Farm

W. L. Hartman Company

Contractor


 Ft. from N. Line

330 Ft. from S. Line

990 Ft. from E. Line

990 Ft. from W. Line

SE SW
SW SE SE

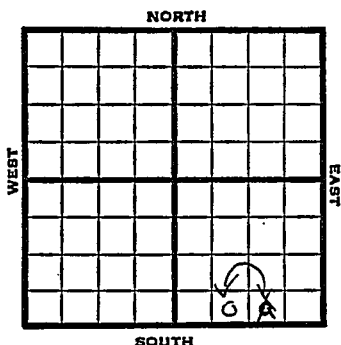

1951 Elev. 1730' REPORT

2/14 Location

5/9 Spud 2-24-51

Oil well TD 3274' 8" @ 195'

Top. 2524', Heeb 2799', Br. lime 2926'

Lans. 2950'

DST 3030-52' open 1/2 hr. rec 30' O & GCM

Simp. sh. 3253', Sand 3265'

5" @ 3268' TD 3270' FU 210' oil

DD 3272' FU 450' oil 12 hr.

DD 3274' FU 300' oil, 850' water

16 hr. SP 3270' 10/3265-68'

Hydrofrac no inc. CO to 3269'

FU 400' oil, 100' water 12 hr.

Comp. 40 BOPD

COMPLETED

County Rice State Kansas

Sec. **36** (Blk. **19** (Sur. **10W** Map No.

Operator W. L. Hartman

Well No. 7 Farm Linke

Elev.	1730	Location	SW SE SE
-------	------	----------	----------

FIRST REPORT

330 Ft. From S Line SE

990 Ft. From E Line Quarter

1st. Report **FEB 14 1951**

Completion

Remarks

Spudding Date _____

Drlg. Data

Location

J. E. TYRA

Kansas

Map No. _____ Sec. 36 Twp. 19 R. 10W

Well No. 7 Linke

W. L. Hartman Company

CORRECTION Contractor

SE SW SE


El. 1732
SECTION PLAT

_____ Ft. from N. Line

330 Ft. from S. Line

_____ Ft. from E. Line

990 Ft. from W. Line

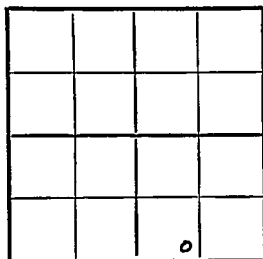

Rice County

Location _____

Rig up _____

Drilling and Remarks:

Reported

SW SE SE

El. 1730

RECORD

Cased _____ in., _____ ft.

Sand _____

Gas _____

OH _____

Total Depth _____

PRODUCTION

1st 24 hrs. Nat. _____

1st 24 hrs. after shot _____

Gas _____ Cu. Ft.

Dry-Hole _____

Abandoned _____

Date

MAR 7 1951

19

J. E. TYRA

Scout

County Rice State Kansas

Sec. 36 (Blk. Twp.) 19 (Sur. Rge.) 10W Map No.

Operator W. L. Hartman

Well No. 7 Farm Linke

Elev. ~~1730~~ Location ~~SW SE SE~~

COMPLETE

330 Ft. From S Line SE

990 Ft. From V Line Quarter

1st. Report _____

Completion MAY 9 1951

Remarks Chase Pool

Spudding Date 2-24-51

Drilg. Data Oil well TD 3274

8" @ 195 Top. 2524 Heeb. 2799

Br. lime 2926 Lans. 2950 DST 3030-52

open $\frac{1}{2}$ hr. Rec. 30' o & gcm Simp. sh. 3253

Sand 3265 5" @ 3268 TD 3270

FU 210' oil DD 3272 FU 450' oil 12 hr.

DD 3274 FU 300' oil 850' water 16 hr.

SP 3270 10/ 3265-68 Hydrofrac no inc.

CO to 3269 FU 400' oil 100' water 12 hr.

Comp. 40 bopd

See Correction

J. E. TYRA