

Rice

KANSAS


Form 51-5M-11-38-Palace

Section 36 Township 19 Range 10-W

Well No. 1 Chas Linke

Company Gulf

NORTH Barngrover Pool

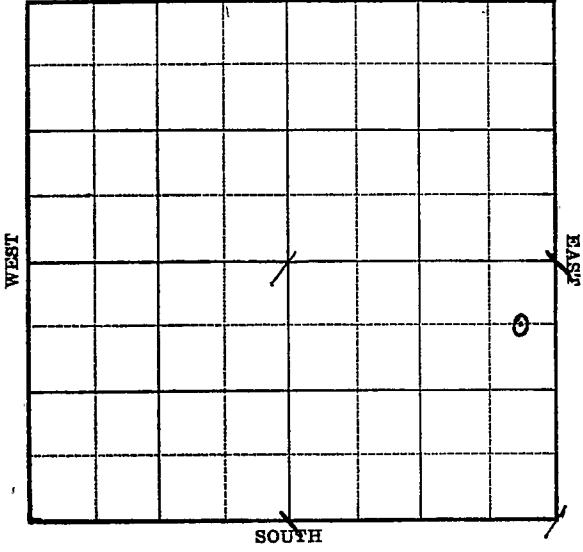

Sec. 36 Twp. 19 R. 10-W

Well No. #1 Chas. Linke Farm _____

Gulf Company _____

(Barngrover)


660 Ft. from N. Line

_____ Ft. from S. Line

330 Ft. from E. Line

_____ Ft. from W. Line

Elev. 1733

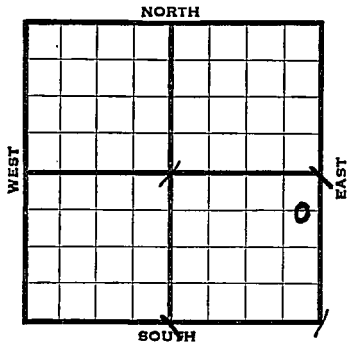

1939	REPORT
4/26	B.R.R.
5/5	13" - 240' Drlg. 1860'
5/12	Drlg. 3115'
5/19	Arb. 3280 - 8" - 3280'
	T.D. 3283' 1500' fluid in hole 2 hrs. Testing for water.
5/24	Arb. 3280'
	8" - 3280'
	T.D. 3283'
	Potential, pump 327 oil & 447
	water.
	COMPLETED

Rice

KANSAS

Map No. 46 Sec. 36 Twp. 19 R. 10WWell No. 1 Chas LinkeGulf

Company

Contractor

FIRST REPORT

C E L N E S E

660 Ft. from N. Line Ft. from S. Line330 Ft. from E. Line Ft. from W. Line

Barngrover Pool

SECTION PLAT

Location _____

Rig up _____

Drilling and Remarks:

BRR

RECORD

Cased _____ in., _____ ft.

Sand _____

Gas _____

Oil _____

Total Depth _____

PRODUCTION

1st 24 hrs. Nat. _____

1st 24 hrs. after shot _____

Gas _____ Cu. Ft.

Dry Hole _____

Abandoned _____

Date

APR 26 1939

19

H. D. Hatfield Scout

Map No. 46 Sec. 36 Twp. 19 R. LOWWell No. 1 Chas LinkeGulf

Company

Contractor

COMPLETED**C E L N E S E**660 Ft. from N. Line Ft. from S. Line330 Ft. from E. Line Ft. from W. Line**BARNGROVER POOL****SECTION PLAT**

			0

Location _____

Rig up _____

Drilling and Remarks:

*Core 3280**8" @ 3280**Pump. P. J.**327 oil 447 Water***RECORD**

Cased _____ in., _____ ft.

Sand _____

Gas _____

Oil _____

Total Depth 3283**PRODUCTION**

1st 24 hrs. Nat. _____

1st 24 hrs. after shot _____

Gas _____ Cu. Ft.

Dry Hole _____

Abandoned _____

Date

MAY 24 1939

19

S. J. LEWIS

Scout