

KANSAS


FORM 51 IOM 12-46-PETROL

Rice

Section 36 Township 19 Range 9-W

Well No. #1 Lowery

Company Drillers Gas

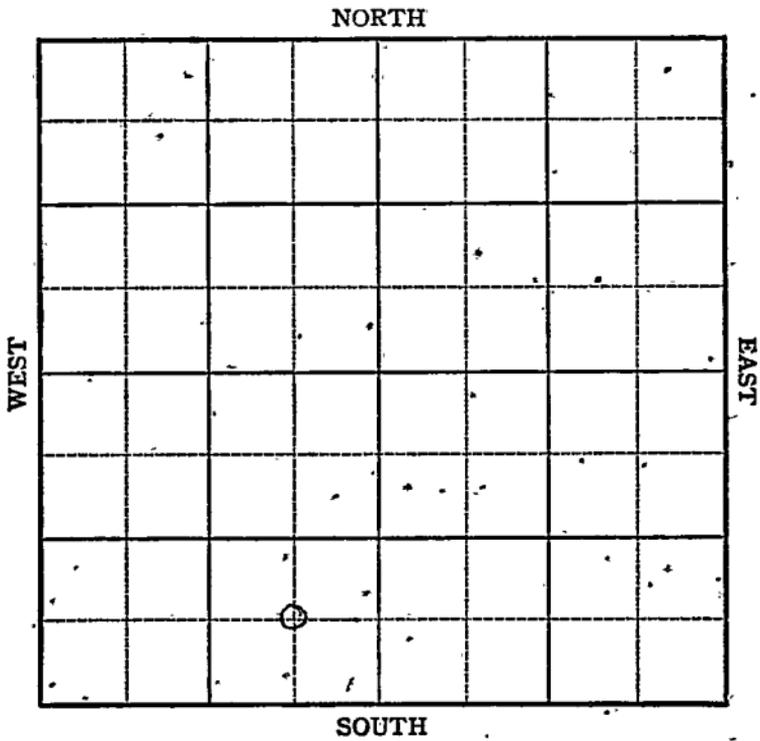

Sec. 36 Twp. 19 R. 9-W

Well No. 1 Lowery Farm

Drillers Gas Company


C SE SW

_____ Ft. from N. Line

660 Ft. from S. Line

660 Ft. from E. Line

_____ Ft. from W. Line

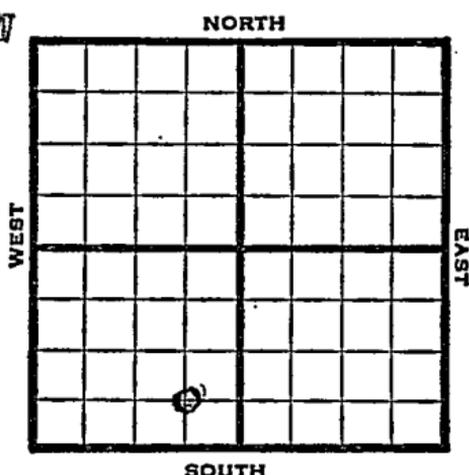

Rice County

1947 1708 REPORT

2-12 RUR

2/19 "

2/26 Tarkio 2117'
Amerceus 1900
5" @ 2193'
TD 2200'
28 shots 2114-26
24 shots 1966-74
Acid 10,000
7,100,000 gas

3/5 Tarkio 2117
5" @ 2193
Perf Tarkio
7,100,000 Gas
693# R Pr
700 BTUs
TD 2200'

COMPLETED

Kansas

KANSAS

Map No. 49 Sec. 36 Twp. 19 R. 9W

Well No. 1 Lowery

Drillers Gas Company

FIRST REPORT Contractor

C SE SW


SECTION PLAT

 Ft. from N. Line

660 Ft. from S. Line

660 Ft. from E. Line

 Ft. from W. Line

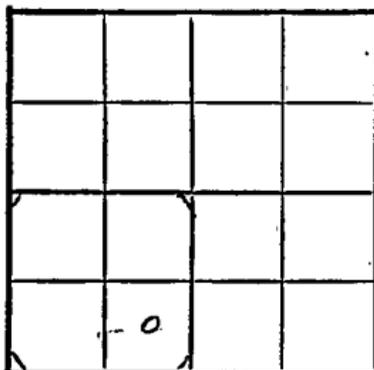

Rice County

RECORD

Location

Cased in., ft.

Rig up

Sand

Drilling and Remarks:

Gas

Oil

Total Depth

R U R

PRODUCTION

1st 24 hrs. Nat.

1st 24 hrs. after shot

Gas Cu. Ft.

Dry Hole

Abandoned

Date

FEB 12 1947 19

S. J. LEWIS

Scout

Kansas

Map No. 49 Sec. 36 Twp. 19 R. 9WWell No. 1 LoweryDrillers Gas CompanyCOMPLETE Contractor

C SE SW

E1,1708
SECTION PLAT

	0		

 Ft. from N. Line660 Ft. from S. Line660 Ft. from E. Line Ft. from W. Line

Rice County

Location Rig up

Drilling and Remarks:

Marked 21175" @ 2173Prof Marked7,100,000 Gas693rd R P₂700 BTU's

RECORD

Cased in., ft.Sand Gas Oil Total Depth 2200

PRODUCTION

1st 24 hrs. Nat. 1st 24 hrs. after shot Gas Cu. Ft.Dry Hole Abandoned

Date

MAR 5 1947 19

S. J. LEWIS

Scout