


KANSAS.

Section 36 Township 19 Range 9N

Company Drillers Gas

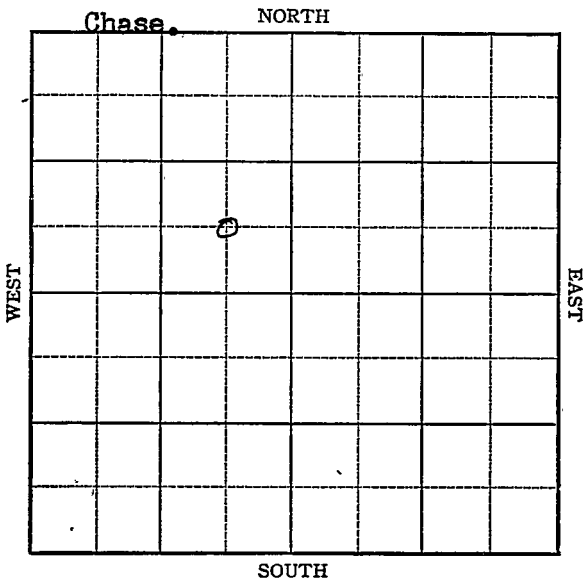

KANSAS

Rice county

Sec. 36 Twp. 19 R. 9W

Well No. 1 Daenzer Farm

Drillers Gas Company

Chase Pool

Ft. from N. Line


660

Ft. from S. Line

660

Ft. from E. Line

Ft. from W. Line

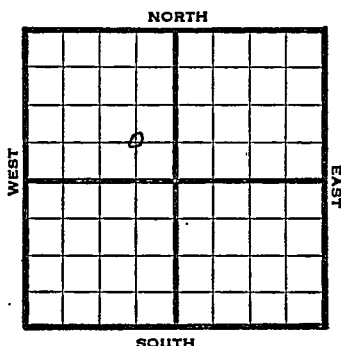

C SE NW

1947

REPORT

5/7

8" @ 120
Drlg. 2122'.

5/14

Tarkio 2125'
5" @ 2126'
648,000 Gas
TD 2129'

COMPLETED

Map No. K49 Sec. 36 Twp. 19 R. 9W

Well No. 1 Daenzer

Drillers Gas Company

FIRST REPORT Contractor

C SE NW


SECTION PLAT

 Ft. from N. Line

660 Ft. from S. Line

660 Ft. from E. Line

 Ft. from W. Line

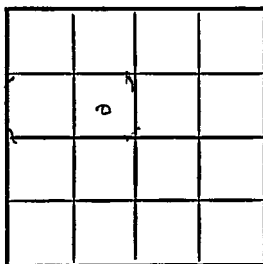

Rice County

Location

Rig up

Drilling and Remarks:

8" @ 120

drlg. 2122

RECORD

Cased in., ft.

Sand

Gas

Oil

Total Depth

PRODUCTION

1st 24 hrs. Nat.

1st 24 hrs. after shot

Gas Cu. Ft.

Dry Hole

Abandoned

Date

MAY 7 1947 19

S. J. LEWIS Scout

Map No. K 49 Sec. 36 Twp. 19 R. 9W

Well No. 1 Daenzer

Drillers Gas Company

COMPLETE Contractor

C SE NW

SECTION PLAT

	0		

 Ft. from N. Line

660 Ft. from S. Line

660 Ft. from E. Line

 Ft. from W. Line

Rice County

Location

Rig up

Drilling and Remarks:

*Test is 2125
 5" 02126
 648,000 Gas*

RECORD

Cased in., ft.

Sand

Gas

Oil

Total Depth 2129

PRODUCTION

1st 24 hrs. Nat.

1st 24 hrs. after shot

Gas Cu. Ft.

Dry Hole

Abandoned

Date

MAY 14 1947

19

S. J. LEWIS

Scout