


Rice

Section 36 Township 19 Range 9W

Well No. 1 Gray "B"

Company Drillers Gas

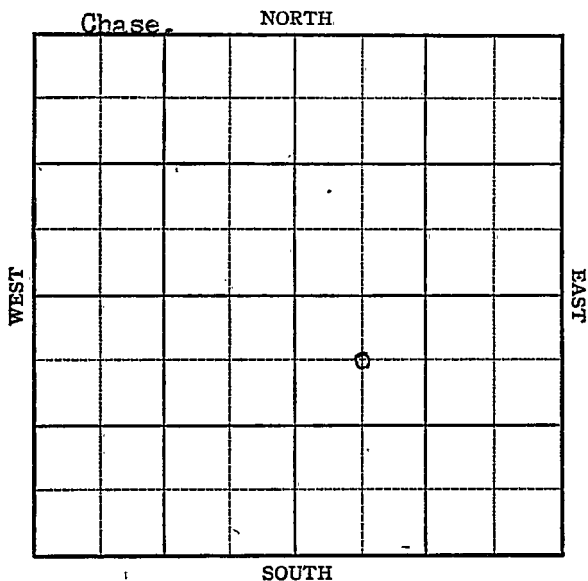

Sec. 36 Twp. 19 R. 9W ✓

Well No. 1 Gray "B" Farm

Drillers Gas Company Company
Chase


660 Ft. from N. Line

 Ft. from S. Line

 Ft. from E. Line

660 Ft. from W. Line

C NW SE

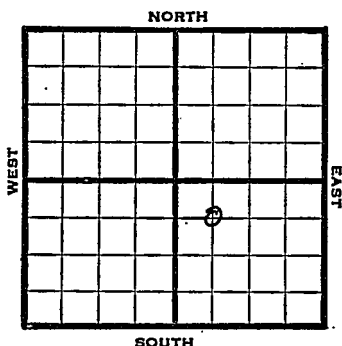

1947 Elev. 1707 REPORT

4/2 Location.

4/9 8" @ 351'
Drlg 1260'

4/15 Topeka 2119'
5" @ 2120' TD
RUST

4/23 " "

4/29 " "

5/7 Tarkio 2119
5" @ 2120
1000 Acid
3,970,000 Gas
TD 2128½'

COMPLETED

Map No. K49 Sec. 36 Twp. 19 R. 9W

Well No. 1 Gray "B"

Drillers Gas Company
FIRST REPORT
Contractor

C NW SE


SECTION PLAT

660 Ft. from N. Line

 Ft. from S. Line

 Ft. from E. Line

660 Ft. from W. Line

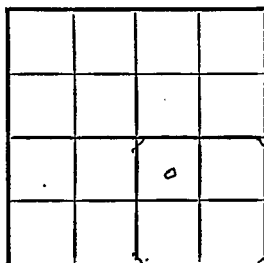

Rice County

Location X

Rig up

Drilling and Remarks:

RECORD

Cased in., ft.

Sand

Gas

Oil

Total Depth

PRODUCTION

1st 24 hrs. Nat.

1st 24 hrs. after shot

Gas Cu. Ft.

Dry Hole

Abandoned

Date

APR 2 1947

19

S. J. LEWIS

Scout

Map No. K49 Sec. 36 Twp. 19 R. 9W

Well No. 1 Gray "B"

Drillers Gas _____ Company _____

COMPLETE

Contractor _____

C NW SE

E1,1707


SECTION PLAT

660 Ft. from N. Line

_____ Ft. from S. Line

_____ Ft. from E. Line

660 Ft. from W. Line

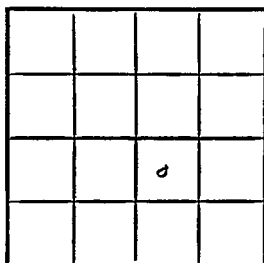

Rice County

Location _____

Rig up _____

Drilling and Remarks:

Tarkio 2/1/7

5' @ 2/20

1000 acid

3,970,000 Gas

RECORD

Cased _____ in., _____ ft.

Sand _____

Gas _____

Oil _____

Total Depth *2728 1/2*

PRODUCTION

1st 24 hrs. Nat. _____

1st 24 hrs. after shot _____

Gas _____ Cu. Ft.

Dry Hole _____

Abandoned _____

Date

MAY 7 1947 19

S. J. LEWIS Scout