


Rice

KANSAS

Section 36 Township 19 Range 9W

Well No. #1 Markel

Company Dozier Oil

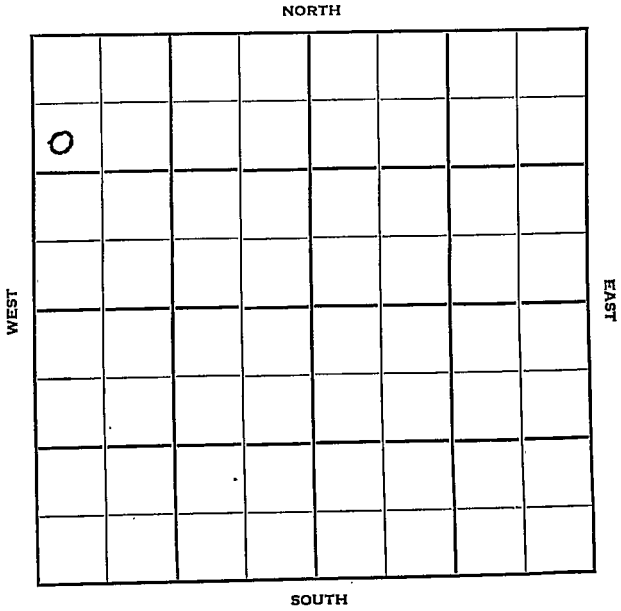

Sec. 36 Twp. 19 R. 9 W

Well No. # 1 Markel Farm

Dozier Oil Company

Stag Contractor


990 Ft. from N. Line

_____ Ft. from S. Line

_____ Ft. from E. Line

330 Ft. from W. Line

SW NW NW

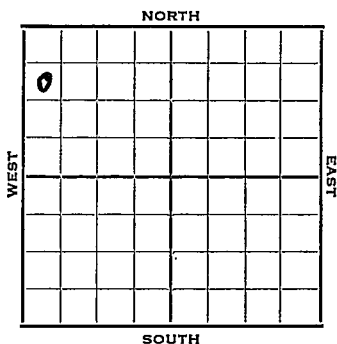

1952

Elev. 1710' REPORT

7/16

Location

7/23

8" @ 161'

Drlg. 2300'

7/30

NR

8/6

Spud 7-17-52

D & A TD 3390' 8" @ 161

Br. line 2861' Lans. 2895'

Viola 3290' Simp. 3314' Arb. 3387'

TD 3390' 5" @ 3379 GO to 3370'

60/3322-42 B/1/2 BWPH PB 2990'

21/2965-69 2000 A S/3/4 BFPH 95% W

D & A

ABANDONED

County Rice State Kansas

Sec. 36 (Blk. 19 (Sur. 9W (Twp. Map No.) Rge.)

Operator Dozier Oil

Well No. 1 Farm Markel

Elev. _____ Location SW NW NW

0					

FIRST REPORT

990 Ft. From N Line NW
330 Ft. From W Line Quarter

1st. Report JUL 1 6 1952

Completion _____

Remarks _____

Stag - Contr.

Spudding Date _____

Drlg. Data _____

Location

J. G. McGEHEE

County Rice State Kansas
 Sec. 36 (Blk.) (Twp.) 19 (Sur.) (Rge.) 9W Map No.
 Operator Dozier Oil
 Well No. 1 Farm Markel
 Elev. 1710 Location SW NW NW

o							

990 Ft. From N Line NW

330 Ft. From W Line Quarter

1st. Report

Completion AUG 6 1952

Remarks

Stagg Drlg. - Contr.

Spudding Date 7-17-52

Drlg. Data D & A TD 3390

8" @ 161 Br. lime 2861 Lans. 2895

Viola 3290 Simp. 3314 Arb. 3387

TD 3390 5" @ 3379 CO to 3370

60/ 3322-42 B/ $\frac{1}{2}$ bwph PB 299021/ 2965-69 2000 A S/ $\frac{3}{4}$ bfph 95% w

D & A