

KANSAS


McPherson

FORM 51 5M 2-38 TPCO.

Section 36 Township 19 Range 2-W

Well No. 1 Becker

Company Jay Kornfeld et al

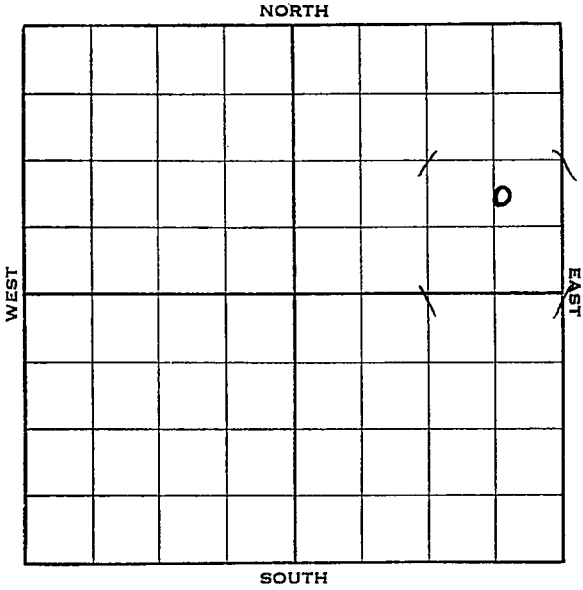

Sec. 36 Twp. 19 R. 2-W

Well No. #1 Becker Farm


Jay Kornfeld et al Company

_____ Ft. from N. Line

920 Ft. from S. Line

600 Ft. from E. Line

_____ Ft. from W. Line

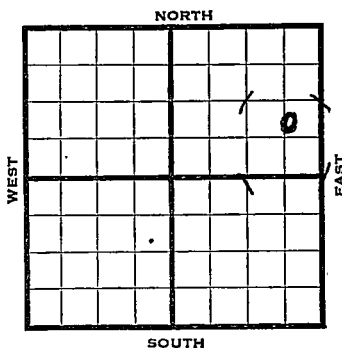

Elev. 1563'

1938	REPORT
9/14	Spud.
9/23	15" - 70'.
	Dlg. 130'.
9/30	12" - 875'.
	Dlg. 1040'.
10/7	10" - 1777'. Dlg. 2215'.
10/14	8" - 2281'. Lans. 2330'.
	H.F.W. 2435-40'. U. R. 8".
10/21	8" - 2458'. 6" - 2946'.
	Chat 2946'. S. G. 2950-55' XXXX
	S. O. 2975-80'. C. O.
10/28	T. D. 2985'. 4 1/2 bailers oil & 1 1/2 bailers water per hour.
11/2	6" - 2946'.
	Chat. 2946'.
	T. D. 2985'.
	Potential 134 bbls.
	Show water.
	COMPLETED

Map No. 43 Sec. 36 Twp. 19 R. 2WWell No. 1 BeckerJay Kornfeld etal

Company

Formerly Lario & shell
Aerege
Contractor

FIRST REPORT

Approx.

C N L 5 E NE~~400~~ Ft. from N. Line920 Ft. from S. Line600 Ft. from E. Line

_____ Ft. from W. Line

SECTION PLAT

			0

Location _____

Rig up _____

Drilling and Remarks:

Spud

RECORD

Cased _____ in., _____ ft.

Sand _____

Gas _____

Oil _____

Total Depth _____

PRODUCTION

1st 24 hrs. Nat. _____

1st 24 hrs. after shot _____

Gas _____ Cu. Ft.

Dry Hole _____

Abandoned _____

Date

SEP 14 1938 19

H. D. Hatfield

Scout

McPherson **KANSAS**Map No. 43 Sec. 36 Twp. 19 R. 2WWell No. 1 BeckerJay Kornfeld etal

Company

Contractor

COMPLETED

Approx.

C N L SE NE

_____ Ft. from N. Line

920 Ft. from S. Line600 Ft. from E. Line

_____ Ft. from W. Line

SECTION PLAT

			○

Location _____

Rig up _____

Drilling and Remarks:

POT 134
S.W.

RECORDCased 6 in., 2946 ft.Sand CHAT 2946

Gas _____

Oil _____

Total Depth 2985**PRODUCTION**

1st 24 hrs. Nat. _____

1st 24 hrs. after shot _____

Gas _____ Cu. Ft.

Dry Hole _____

Abandoned _____

Date

NOV 2 - 1938

19

H. D. Hatfield Scout