

Sec. 36 Twp. 19 R. 2-W

Well No. #1 Becker Farm

Chas. Gould et al Company


Canton Pool

_____ Ft. from N. Line

990' Ft. from S. Line

_____ Ft. from E. Line

990' Ft. from W. Line

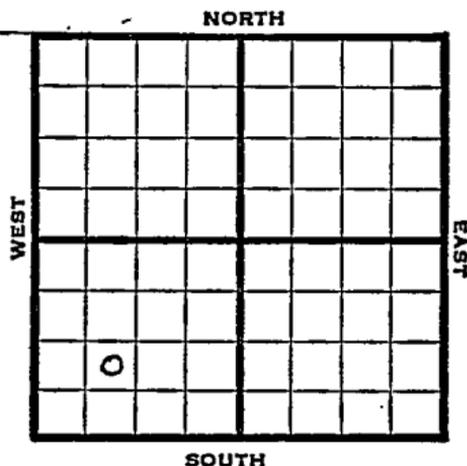

NE SW SW

REPORT

1947

11/12 All wells plugged

11/19 8" @ 112'
Drlg. 850'

11/25 Drlg. 2400'

12/3 Mississippi 2934'
TD 2944'
Run 5"

12/10 5" @ 2943'
RUST

12/23 Miss. 2934'
5" @ 2943'
Pump 10 oil / 30W Pot
Gr. 38.0
TD 2983'

COMPLETED

Map No. _____ Sec. 36 Twp. 19 R. 2W

Well No. 1 Becker

Chas. Gould et al. Company

BEST RESULT Contractor

NE SW SW

SECTION PLAT

_____ Ft. from N. Line

990 Ft. from S. Line

_____ Ft. from E. Line

990 Ft. from W. Line

McPherson County

Location _____

Rig up _____

Drilling and Remarks:

all wells plugged

RECORD

Cased _____ in., _____ ft.

Sand _____

Gas _____

Oil _____

Total Depth _____

PRODUCTION

1st 24 hrs. Nat. _____

1st 24 hrs. after shot _____

Gas _____ Cu. Ft.

Dry Hole _____

Abandoned _____

Date

NOV 12 1947

19

S. J. LEWIS

Scout

