


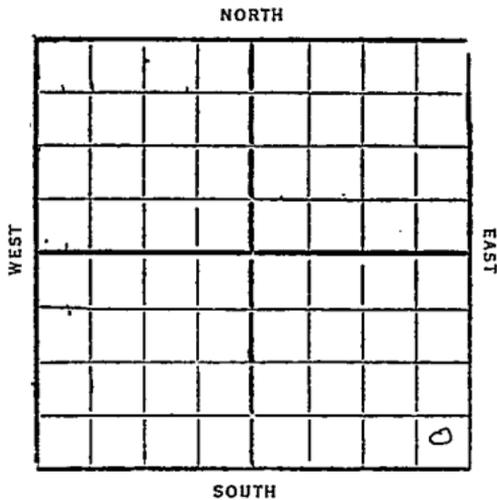

Map No. KANSAS Sec. 36 Twp. 19 R. 2<sup>w</sup>

Well No. 1 - Beecher Farm  
Syndicate & Shell Company

\_\_\_\_\_ Ft. from N. Line  
330 Ft. from S. Line  
330 Ft. from E. Line  
\_\_\_\_\_ Ft. from W. Line  
1930



Date	REPORT
12/30	Loc.
1/31	Rod.
1/17	Run up
1/14	Spud
1/21	" 315'
1/28	drlg 645'
2/14	" 1155'
2/11	" 1580'
2/18	" 1930'
2/25	" 2285'
3/4	" 2410'
3/11	" 2520'
3/18	Top Chat <del>2920</del> 2926
3/25	TD. 2922' UIR 8"
4/1	
4/8	T.D. 2922' (Dm 8" there
4/15	Top Chat 2926' (5 L.M.)
	2 1/2 # gas 2936
	drlg ahead
4/22	SD 2955'
	(over)

4/29- 8"-2926  
First oil at 2970  
Increase oil & show water  
from 2970-90

S/R 8" CSY  
5/6- Drlg 3042'  
5/13- 6"-3079  
Drlg 3105'

5/20- 5"-3385  
Viola 3398-3412  
Hole full oil  
No test

5/27- TD 3418  
shot 15 qt 3402-17  
swab 152 bbl 6 hrs

6/3- TD 3418'  
shot 40 qt 3398-3417  
swab 277 bbl 7 hrs

6/10- Viola 3398-3418  
TD 3418'

shot 15 qt 3402-17  
" 40 qt 3398-3417  
1214 bbl oil  
potential gauge  
Comp.

*M. H. Norton*


Map No. **KANSAS** Sec. *26* Twp. *19* R. *2W*

*43*  
Well No. *1 Breaker*

*Syndicate Oil & Shell* Company  
Contractor

**SECTION PLAT**

..... Ft. from N. Line  
*220* Ft. from S. Line  
*230* Ft. from E. Line  
..... Ft. from W. Line

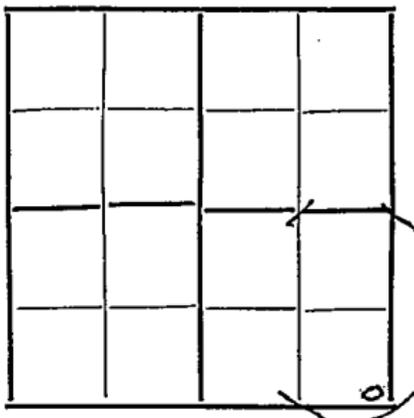

**FIRST REPORTS**

Location *✓*.....  
Rig up.....  
Drilling and Remarks:  
.....  
.....  
.....

**RECORD**  
Cased..... in., ..... ft.  
Sand.....  
Gas.....  
Oil.....  
Total Depth.....

**PRODUCTION**  
1st 24 hrs. Nat.....  
1st 24 hrs. after shot.....  
Gas..... Cu. Ft.  
Dry Hole.....  
Abandoned.....

Date .....  
*DEC 20 1930* .....  
*S. J. LEWIS* Scout

*[Handwritten scribbles]*

Returned	<i>[scribble]</i>
Cards	<i>[scribble]</i>
Tracing	<i>[scribble]</i>
France Map	<i>[scribble]</i>
Scarborough Map	<i>[scribble]</i>
Moody Map	<i>[scribble]</i>
Scarborough Cat Book	<i>[scribble]</i>
1900's Put Book	<i>[scribble]</i>

*McPherson*

Map No. 43 Sec. 36 Twp. 19 R. 2 <sup>W</sup>

Well No. 1 *Becker*

*Syndicato O+G & Shee* Company

Contractor

**COMPLETED**

**SECTION PLAT**

..... Ft. from N. Line  
330 Ft. from S. Line  
330 Ft. from E. Line  
 ..... Ft. from W. Line

			0

Location.....

Rig up.....

Drilling and Remarks:

*15/3402-17'*

*40/3398-3417'*

*Potential Prod*

*1214 Bls.*

**RECORD**

Cased..... in., ..... ft.

Sand *Viola 3398-3418*

Gas.....

Oil.....

Total Depth..... *3418*

**PRODUCTION**

1st 24 hrs. Nat.....

1st 24 hrs. after shot.....

Gas..... Cu. Ft.

Dry Hole.....

Abandoned.....

Date

**JUN 1 0 1931**

**CHAS. L. SHERWOOD**



Returned	
Cards	<i>JG</i>
Tracing	<i>cut</i>
France Map	<i>+</i>
Scarborough Map	<del>_____</del>
Moody Map	<i>+</i>
Scarborough Flat Book	<del>_____</del>
Moody Flat Book	<del>_____</del>