


M. C. Pherson

Map No. KANSAS Sec. 36 Twp. 19 R. 2^W
 Well No. 4 Johnson Farm
Open + shell Company

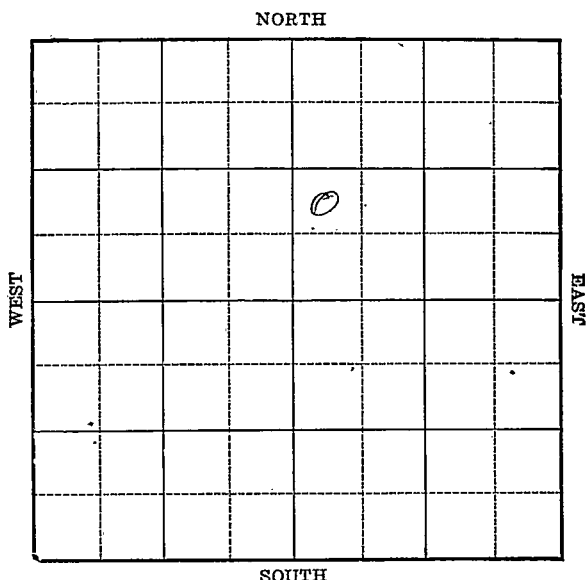

Location _____
 Drilling Remarks _____

Rig Up _____
 Drilling Remarks _____

RECORD

Cased _____ in. _____ ft.
 Sand _____
 Gas _____
 Oil _____
 Total Depth _____

PRODUCTION

1st 24 hrs. Nat. _____
 1st 24 hrs. after shot _____
 Gas _____ cu. ft.
 Dry Hole _____
 Abandoned _____

McPherson

Map No. KANSAS Sec. 36 Twp. 19 R. 2W

Well No. 4 - Johnson Farm


Olson + Shell Company

 Ft. from N. Line

990 Ft. from S. Line

 Ft. from E. Line

330 Ft. from W. Line

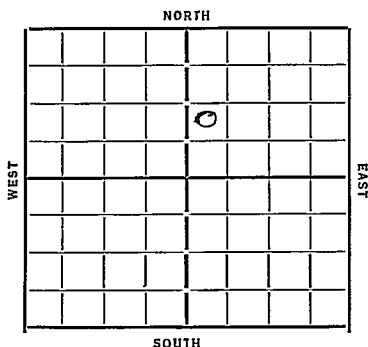

Date

REPORT

1933

9/27

D/G. 547'

10/5

" 2593'

10/11

T. Chat 2943 - hreg 3320

10/18

6" at 3388 - R.H.S.T.

10/25

11/1

Viola 3392 T.D. 3412' - 1000 gal
acid pump 130 bbls
COMPLETED

Map No. 43 Sec. 36 Twp. 19 R. 2WWell No. 4 - JohnsonOlson & Shell Company


Contractor

SECTION PLAT

Ft. from N. Line

990 Ft. from S. Line

Ft. from E. Line

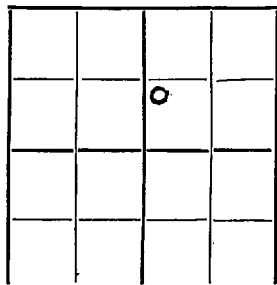330 Ft. from W. Line

FIRST REPORTS

Location.....

Rig up.....

Drilling and Remarks:

14 547

RECORD

Cased.....in.,ft.

Sand.....

Gas.....

Oil.....

Total Depth.....

PRODUCTION

1st 24 hrs. Nat.....

1st 24 hrs. after shot.....

Gas.....Cu. Ft.


Dry Hole.....

Abandoned.....

Date SEP 27 1933

192

O. Mannick Scout

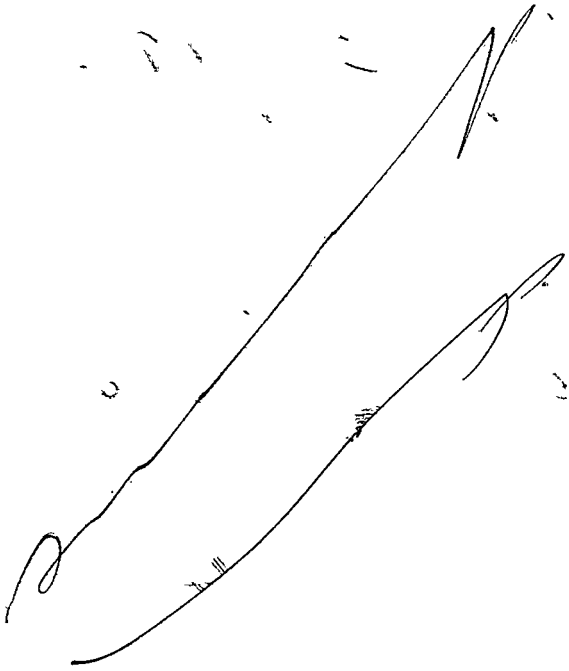

Returned	
Cards	
Tracing	
France Map	
Scarborough Map	
Moody Map	
Scarborough Flat Book	
Moody Flat Book	

Map No. 43 Sec. 36 Twp. 19 R. 2WWell No. H- JohnsonOlson & Shell Company

Contractor

SECTION PLAT

Ft. from N. Line

990 Ft. from S. Line

Ft. from E. Line

330 Ft. from W. Line**COMPLETED**

Location

Rig up

Drilling and Remarks:

1000 gal acidPump 130 lbs

RECORD

Cased _____ in. _____ ft.

Sand Viola 3392

Gas _____

Oil _____

Total Depth 3412

PRODUCTION

1st 24 hrs. Nat. _____

1st 24 hrs. after shot _____

Gas _____ Cu. Ft.

Dry Hole _____

Abandoned _____

Date

11-1-33 192 O. Mannish Scout

Returned

to Is.

for

France Map

Scarborough Map

Moody Map

Scarborough Flat Book

Moody Flat Book