

Sec. 36 Twp. 19 R. 2W

Well No. #1 Miller Farm

Geo. Hess Company

Ritz-Canton Pool

Contractor


Ft. from N. Line

330' Ft. from S. Line

Ft. from E. Line

990' Ft. from W. Line

SE SW SE

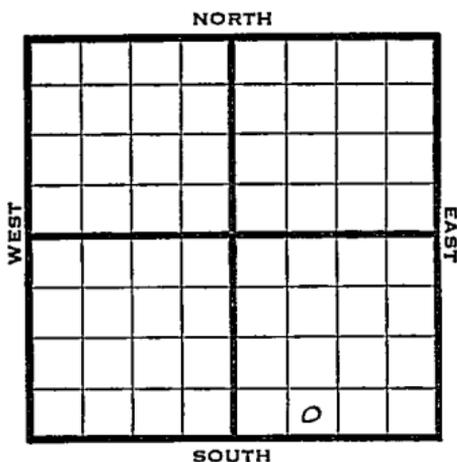

1949

Elev 1558'

REPORT

11/2

8" @ 125'
Miss 2931-36. TD

5" @ 2935'

11/9

TD 2977'
Miss 2981'
Aband.

ABANDONED

Kansas

Ritz-Canton Po

Map No. _____ Sec. 36 Twp. 19 R. 2W

Well No. 1 Miller

Geo. Hess _____ Company

Contractor

SE SW SE

FIRST REPORT
SECTION PLAT

_____ Ft. from N. Line

330 Ft. from S. Line

_____ Ft. from E. Line

990 Ft. from W. Line

			0

McPherson County

Location _____

Rig up _____

Drilling and Remarks:

8" @ 125

Miss. 2931-36 TD

5" @ 2935

RECORD

Cased _____ in., _____ ft.

Sand _____

Gas _____

Oil _____

Total Depth _____

PRODUCTION

1st 24 hrs. Nat. _____

1st 24 hrs. after shot _____

Gas _____ Cu. Ft.

Dry Hole _____

Abandoned _____

Date

NOV 2 1949 19

S. J. LEWIS

Scout

Kansas

Map No. _____ Sec. 36 Twp. 19 R. 2W

Well No. 1 Miller

Geo. Hess _____ Company

ABANDONED

Contractor

SE SW SE

E. 1038
SECTION PLAT

_____ Ft. from N. Line

330 Ft. from S. Line

_____ Ft. from E. Line

990 Ft. from W. Line

McPherson County

Location _____

Rig up _____

Drilling and Remarks:

Miss 2981

RECORD

Cased _____ in., _____ ft.

Sand _____

Gas _____

Oil _____

Total Depth 2977

PRODUCTION

1st 24 hrs. Nat. _____

1st 24 hrs. after shot _____

Gas _____ Cu. Ft.

Dry Hole _____

Abandoned _____

Date

NOV 9 1949

19

S. J LEWIS

Scout