


Section 36 Township 19 Range 1-W

Well No. #1 Wallace

Company J. H. Hershey

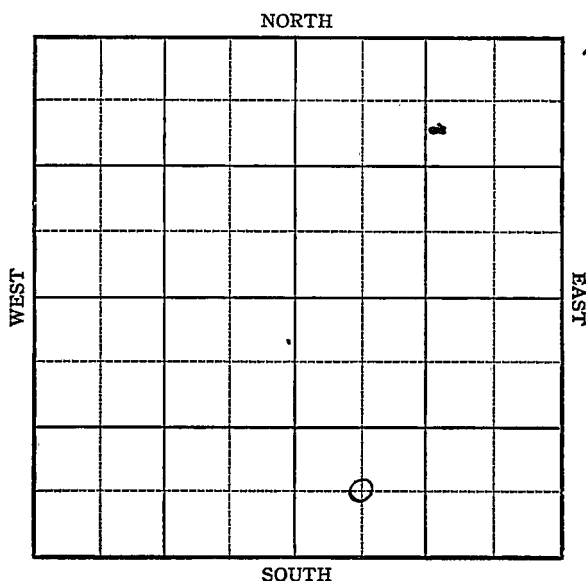

KANSAS


McPherson

Sec. 36 Twp. 19 R. 1-W

Well No. #1 Wallace Farm

J. H. Hershey Company

NORTH

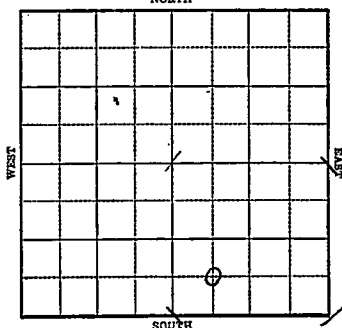

 Ft. from N. Line

660 Ft. from S. Line

 Ft. from E. Line

660 Ft. from W. Line

Elev. 1570

1943

R E P O R T

11/3 Location

11/10 "

11/17 8" @ 105'

WOC

12-1 Miss 2901

TD 2931


ABANDONED

KANSAS

Map No. 43 Sec. 36 Twp. 19 R. 1WWell No. 1 WallaceJ. H. Hershey CompanyFIRST REPORT Contractor

C SW SE

SECTION PLAT

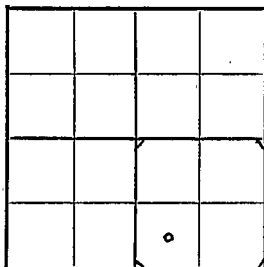 Ft. from N. Line660 Ft. from S. Line Ft. from E. Line660 Ft. from W. Line

Wildcat

Location XRig up

Drilling and Remarks:

RECORD

Cased in., ft.Sand Gas Oil Total Depth

PRODUCTION

1st 24 hrs. Nat. 1st 24 hrs. after shot Gas Cu. Ft.Dry Hole Abandoned

Date

NOV 3 1943

19

S. J. LEWIS Scout

KANSAS

Map No. 42 Sec. 36 Twp. 19 R. 1WWell No. 1 WallaceJ. H. Hershey CompanyABANDONED Contractor

C SW SE

SECTION PLAT

		o	

 Ft. from N. Line660 Ft. from S. Line Ft. from E. Line660 Ft. from W. Line

Wildcat

Location Rig up

Drilling and Remarks:

Miss 2901

RECORD

Cased in., ft.Sand Gas Oil Total Depth 2931

PRODUCTION

1st 24 hrs. Nat. 1st 24 hrs. after shot Gas Cu. Ft.Dry Hole Abandoned

Date

DEC 1 1943 19 S. J. LEWIS Scout