


Rice

FORM 51 IOM 12-46 PETROL KANSAS

Section 36 Township 19 Range 10W

Well No. 1 Kropf

Company W. L. Hartman

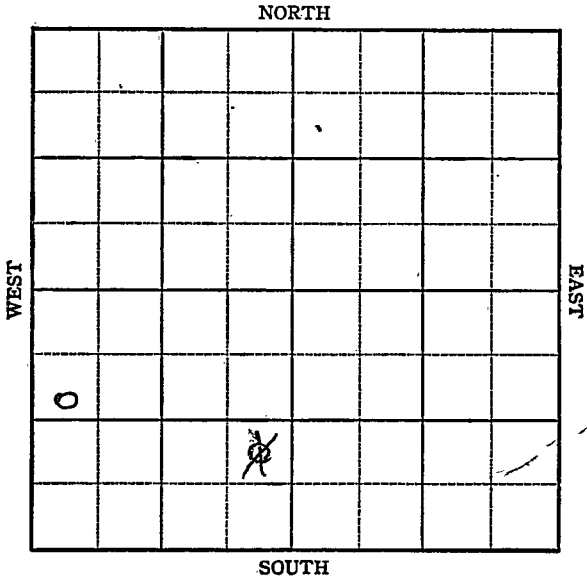

KANSAS <sup>Rice</sup>

Sec. 36 Twp. 19 R. 10-W

Well No. #1 Kropf Farm

W. L. Hartman Company  
Silica

1250 Ft. from N. Line


990 Ft. from S. Line

330 Ft. from E. Line

330 Ft. from W. Line

Sw-Nw-Sw

~~NE SE SW~~

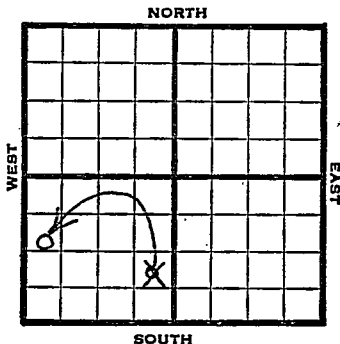

REPORT

1947

5/14 Location

5/20 "

5/27 "

6/3 "

6/10 "

6/17 "

6/24 "

7/1 "

7/8 "

7/16 "

7/22 "

7/29 "

8/6 "

8/13 "

8/20 "

8/27 "

9/3 "

OVER

1947

9/10 Loc.

9/17 "

9/24 "

10/1 "

10/8 "

10/15 10" @ 410'  
Drlg. 1365'

10/22 Lansing 2964'  
BKC 3227'  
Conglomerate 3273'  
TD 3276'  
5" @ 3275'  
RUST

10/29 "

11/5 Arbuckle 3280'  
TD 3283'  
4" liner @ 3280'  
2500 oil in 13 hrs.

11/12 Pump 25 bbls. oil 24 hrs.

11/19 "

11/25 "

12/3 "

12/10 "

12/17 Arbuckle 3280'  
5" @ 3275'  
Pump 50 Pot  
TD 3283'  
Gravity 42.7

**COMPLETED**

Map No. 46 Sec. 36 Twp. 19 R. 10W

Well No. 1 Kropf

W. L. Hartman Company

CORRECTION Contractor

SW NW SW

1250 Ft. from N. Line

\_\_\_\_\_ Ft. from S. Line

\_\_\_\_\_ Ft. from E. Line

330 Ft. from W. Line

SECTION PLAT


Rice County

Location \_\_\_\_\_

Rig up \_\_\_\_\_

Drilling and Remarks:

Reported

NE SE SW

RECORD

Cased \_\_\_\_\_ in., \_\_\_\_\_ ft.

Sand \_\_\_\_\_

Gas \_\_\_\_\_

Oil \_\_\_\_\_

Total Depth \_\_\_\_\_

PRODUCTION

1st 24 hrs. Nat. \_\_\_\_\_

1st 24 hrs. after shot \_\_\_\_\_

Gas \_\_\_\_\_ Cu. Ft.

Dry Hole \_\_\_\_\_

Abandoned \_\_\_\_\_

Date

OCT 15 1947 19 \_\_\_\_\_

S. J. LEWIS Scout

Misc. Small Maps

Cards

Tracing

France Map

Scarborough Map

Pierce Map

Geological Dept.

Pierce Plat Book



Misc. Small Maps

Cards *Elaine*

Tracing *J. D.*

France Map *J. D.*

Geographical Map *J. D.*

Physical Map *J. D.*

Cecological Dept. \_\_\_\_\_

Pierce Plat Book \_\_\_\_\_

Kansas

Silica

Map No. K 46 Sec. 36 Twp. 19 R. 10WWell No. 1 KropfW. L. Hartman CompanyFIRST REPORT Contractor

NE SE SW

## SECTION PLAT

	0		

       Ft. from N. Line990 Ft. from S. Line330 Ft. from E. Line       Ft. from W. LineRice CountyLocation XRig up       

Drilling and Remarks:

## RECORD

Cased        in.,        ft.Sand       Gas       Oil       Total Depth       

## PRODUCTION

1st 24 hrs. Nat.       1st 24 hrs. after shot       Gas        Cu. Ft.Dry Hole       Abandoned       

Date

MAY 1 4 1947 19S. J. LEWIS Scout

Misc. Small Maps	<u>6</u>
Cards	<u>22</u>
Tracing	<u>1</u>
France Map	<u>1</u>
Scarborough Map	<u>1</u>
Pierce Map	<u>1</u>
Geological Dept.	<u>1</u>
Pierce Plat Book	<u>1</u>