

KANSAS


FORM 51 5M 1-42 PETROL

Rice

Section 36 Township 19 Range 9-W

Well No. #1 W. Dinsmore

Company Max Steinbushel

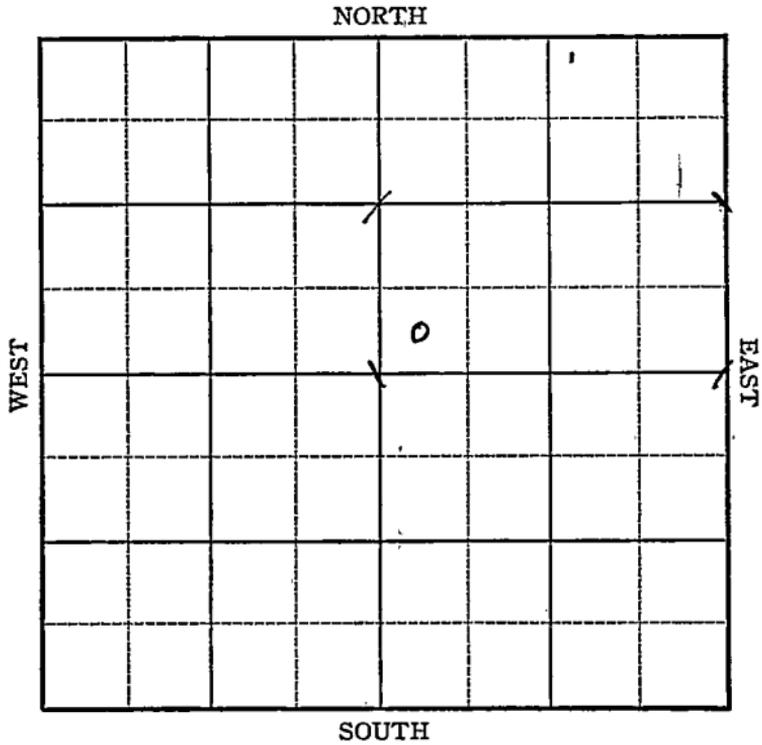

Sec. 36 Twp. 19 R. 9 W

Well No. #1 W. Dinsmore Farm

Max Steinbushel Company

Wildcat


_____ Ft. from N. Line

330 Ft. from S. Line

_____ Ft. from E. Line

330 Ft. from W. Line

Elev. 1711

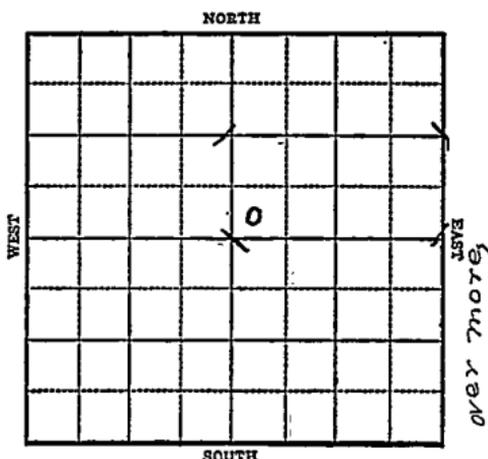

1943

R E P O R T

6/16	Cable rig.
6/23	"
6/30	"
7/7-	"
7/14	"
7/21	"
7/28	"
8/4	"
8/11	"
8/18	"
8/25	"
9/1	"
9/8	"
9/15	"
9/22	Spud
9/29	15" @ 200'
	Drlg. 400'
10/6	Drlg. 1150'
10/13	10" @ 1705'
	Drlg. 1780'
10/20	1650 fsg.
10/27	Anhy 292
	T.D. 1983'
	Run 8"

OVER

1943
11/3 8" @ 2011'
T.D. 2125'
W.R. 8"
11/10 8" @ 2130
Topeka 2440
Drlg. 2575'
11/17 8" @ 2800
Lans 2920
Drlg. 3110'
11/24 5" @ 3227
Congl 3233
Drlg. 3255
12/1 Arb. 3254
HFW 3287
Drlg. 3293
12/8 "
12/15 "
12/22 Arb 3254
TD 3293
HFW

ABANDONED

Misc. Serials *Qma*
C. S. Madge
T. *WEL*
Finger Map
Coastal *WEL*
Moody Map *WEL*
Biological Dept
Moody Plat Book

Map No. KAANS Sec. 36 Twp. 19 R. 9W
 Well No. 1 W. Dinsmore

Rice

Max Steinbushel

Company

FIRST REPORT

Contractor

SW NE

SECTION PLAT

_____ Ft. from N. Line

330 Ft. from S. Line

_____ Ft. from E. Line

330 Ft. from W. Line

WILDCAT

Location _____

Rig up _____

Drilling and Remarks:

Cable Rig

RECORD

Cased _____ in., _____ ft.

Sand _____

Gas _____

Oil _____

Total Depth _____

PRODUCTION

1st 24 hrs. Nat. _____

1st 24 hrs. after shot _____

Gas _____ Cu. Ft.

Dry Hole _____

Abandoned _____


Date

JUN 16 1949

19

S. J. LEWIS

Scout

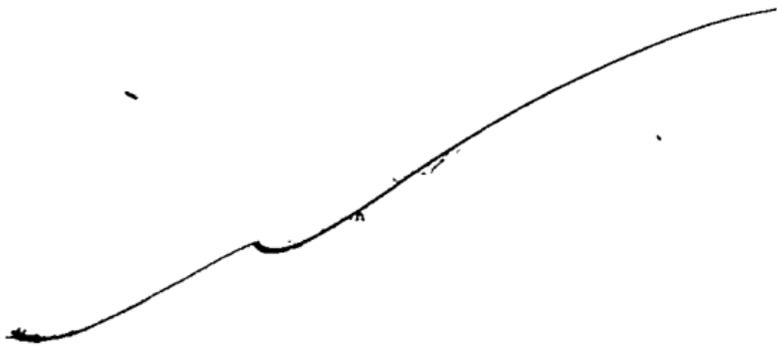

Misc Small Maps	<i>Original</i>
Cards	<i>MB</i>
Tracing	<i>MB</i>
France Map	<i>MB</i>
Scarborough Map	<i>MB</i>
Moody Map	<i>MB</i>
Geological Dept.	
Moody Flat Book	