
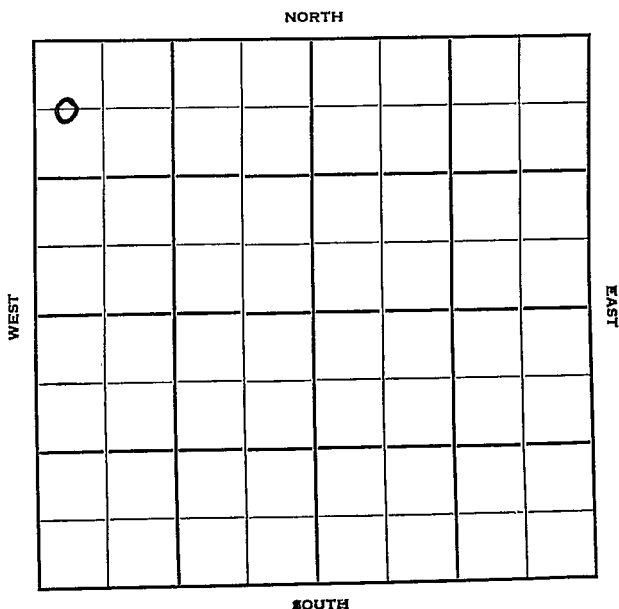


Section 36 Township 19 Range 14 WWell No. # 1 Poor FarmCompany Ben Hyde Jr.

Sec. 36 Twp. 19 R. 14WWell No. #1 Poor Farm FarmBen Hyde Jr. CompanyHilton Contractor660 Ft. from N. Line Ft. from S. Line Ft. from E. Line330 Ft. from W. Line

C W/2 NW NW

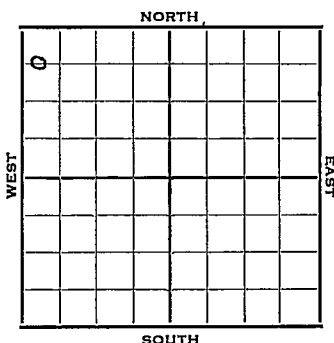

1952 Elev. 1873' REPORT

4/30 Spud 4-24-52
785' anhy
8" @ 797'
Dr1g. 1766'

5/7 Heeb 3105' Br. 11 3201' Lans. 3213'
SO 3215-24'
DST 3215-25, 1/2 hr, 4' M, NS
SO 3276-82'
DST 3272-87', 1/2 hr, 8' M, NS
DST 3352-3404', 1/2 hr.

5/13 Spud 4-24-52
D&A TD 3505 Anhy 785'
8" @ 797' Heeb. 3105 Br Li 3201
Lans. 3213 SO 3215-24'
DST 3215-25 open $\frac{1}{2}$ hr. rec. 4' mud
SO 3276-82 DST 3272-87 open $\frac{1}{2}$ hr.
Rec. 8' mud DST 3352-3404 open $\frac{1}{2}$ hr.
Rec. 15' mud Sh. Cong. 3453
Ch. Cong. 3460' TD 3505'
D&A

ABANDONED

County Barton State Kansas
 Sec. 36 (Blk.) 19 (Sur.) 14W Map No.

Operator Ben Hyde Jr.

Well No. 1 Farm Poor Farm

Elev. 1873 Location C W/2 NW NW

660 Ft. From N Line NW

330 Ft. From W Line Quarter

1st. Report APR 30 1952

Completion

Remarks

Hilton - Contr.

Spudding Date 4-24-52

Drlg. Data

Anhy 785 8" @ 797 Drlg. 1766

J. G. McGEHEE

County Barton State Kansas
 Sec. 36 (Bk. 19 (Sur. 14W Map No.)
 (Twp.) (Rge.)

Operator Ben Hyde Jr.

Well No. 1 Farm Poor Farm

Elev. 1873 Location C W L NW NW

0									

660 Ft. From N Line NW

330 Ft. From W Line Quarter

1st. Report

Completion MAY 14 1952

Remarks

Hilton - Contr.

Spudding Date 4-24-52

Drilg. Data D & A TD 3505

Anhy 785 8" @ 797 Heeb. 3105

Br. lime 3201 Lans. 3213 SO 3215-24

DST 3215-25 open $\frac{1}{2}$ hr. Rec. 4' mud

SO 3276-82 DST 3272-87 open $\frac{1}{2}$ hr.

Rec. 8' mud DST 3352-3404 open $\frac{1}{2}$ hr.

Rec. 15' mud Sh. Cong. 3453 Ch. Cong.

3460 TD 3505

D & A

J. G. McGEHEE -