


Section 36 Township 19 Range 12W

Well No. #1 Richardson

Company Berwick-Spurill & Harms

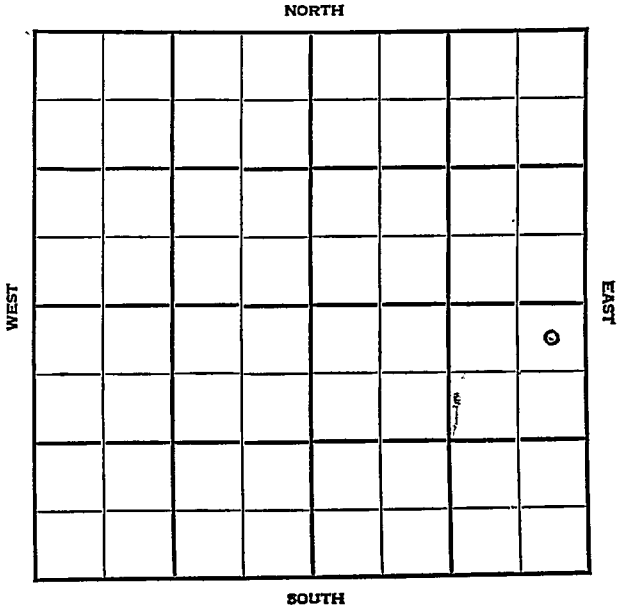

KANSAS

Barton

Sec. 36 Twp. 19 R. 12W

Well No. #1 Richardson Farm

Berwick-Spurill & Harms Company

Silica Pool


330' Ft. from N. Line

Ft. from S. Line

330' Ft. from E. Line

Ft. from W. Line

NE SE

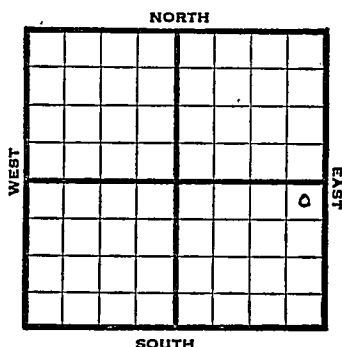

1948 Elev. 1790' REPORT

2/4 8" @ 180'
WOC

2/11 Drlg. 2860'

2/18 Lans. 3087'
Simp. 3341'
TD 3385'
Abd.

ABANDONED

Map No. _____ Sec. 36 Twp. 19 R. 12W

Well No. 1 Richardson

Berwick-Spurill & Harms Company

FIRST REPORT

Contractor

NE SE


SECTION PLAT

330 Ft. from N. Line

_____ Ft. from S. Line

330 Ft. from E. Line

_____ Ft. from W. Line

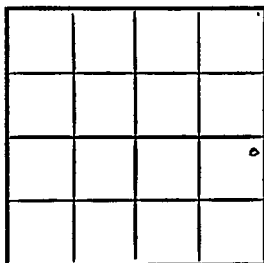

Barton County

Location _____

Rig up _____

Drilling and Remarks: .

8"@ 180 WOC

RECORD

Cased _____ in., _____ ft.

Sand _____

Gas _____

Oil _____

Total Depth _____

PRODUCTION

1st 24 hrs. Nat. _____

1st 24 hrs. after shot _____

Gas _____ Cu. Ft.

Dry Hole _____

Abandoned _____

Date

FEB 4 1948

19

S. J. LEWIS

Scout

Form 26 200 Bks. 10-46 Petrol
Kansas

Silica Pool

Map No. 46 Sec. 36 Twp. 19 R. 12W

Well No. 1 Richardson

Berwick-Spurriel & Harms Company

ABANDONED

Contractor

NE SE


E 11780
SECTION PLAT

330 Ft. from N. Line

_____ Ft. from S. Line

330 Ft. from E. Line

_____ Ft. from W. Line

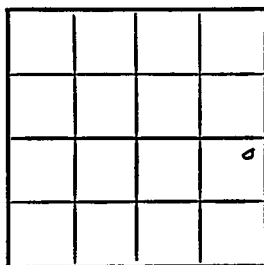

Barton County

Location _____

Rig up _____

Drilling and Remarks:

L. one 3087

Simp 3341

RECORD

Cased _____ in., _____ ft.

Sand _____

Gas _____

Oil _____

Total Depth 3350

PRODUCTION

1st 24 hrs. Nat. _____

1st 24 hrs. after shot _____

Gas _____ Cu. Ft.

Dry Hole _____

Abandoned _____

Date

FEB 18 1948

19

S. J. LEWIS

Scout