


Section 36 Township 19 Range 12W

Well No. #1 Hammeke "C"

Company W.L. Hartman

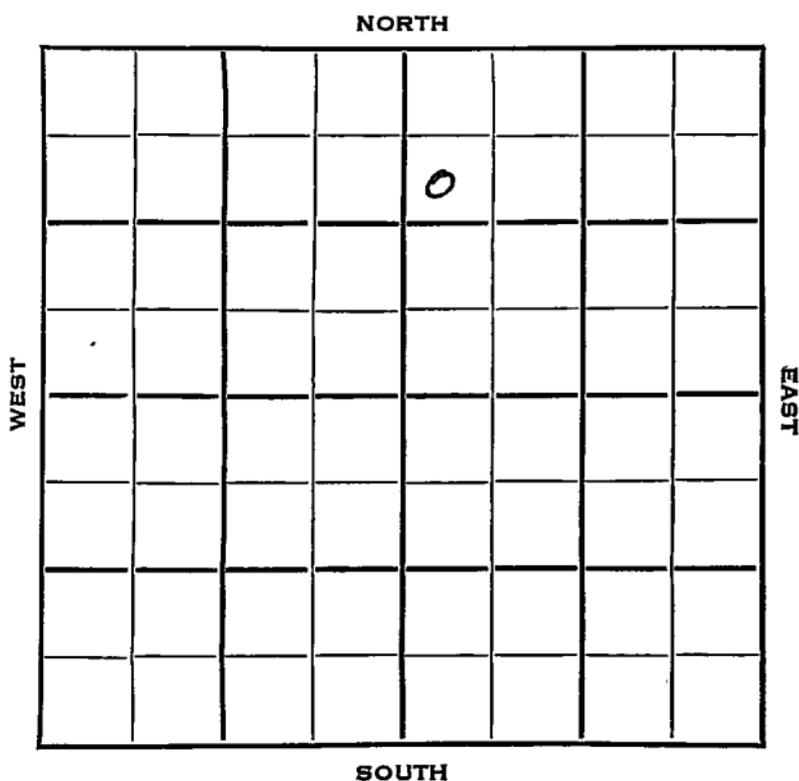

Barton KANSAS


SEC. 36	TWP. 19	R. 12W
------------	------------	-----------

WELL NO. 1 Hammeke "C" FARM

COMPANY W. L. Hartman

CONTRACTOR

990 Ft. from N. Line
 Ft. from S. Line
 Ft. from E. Line
 330 Ft. from W. Line

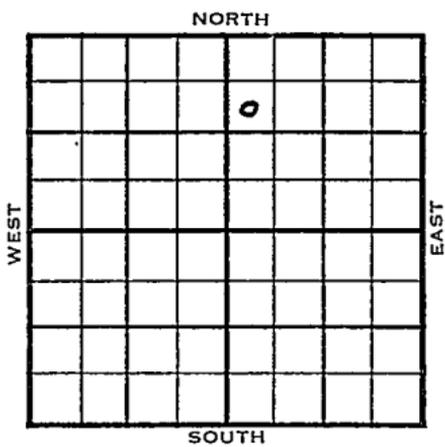

SW NW NE

1954	ELEVATION 1796'	REPORT
------	--------------------	--------

1/6 8" @ 156'
 Drlg. 1465'

1/13 NR

1/20 Spud 1-2-54 D & A TD 3380
 8" @ 156 Top. 2721 Heeb 2961
 B. Oread 2992 Br lime 3080
 Lans. 3096 B KC 3340 Arb. 3349
 TD 3380' D & A

ABANDONED

