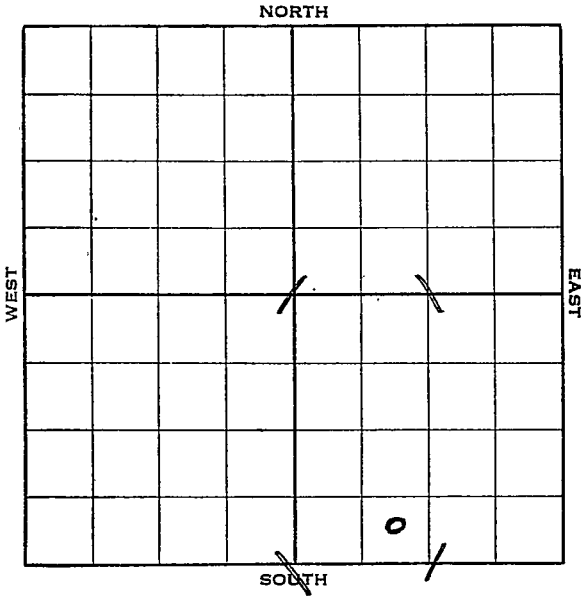



FORM 51 5M 2-38 TPCO
KANSASSection 36 Township 19 Range 12-WWell No. #1 WolfCompany Crown Petroleum

KANSAS

Barton

Sec. 36 Twp. 19 R. 12-WWell No. #1 Wolf FarmCrown Petr. Company Ft. from N. Line330 Ft. from S. Line Ft. from E. Line990 Ft. from W. Line

Elev. 1792

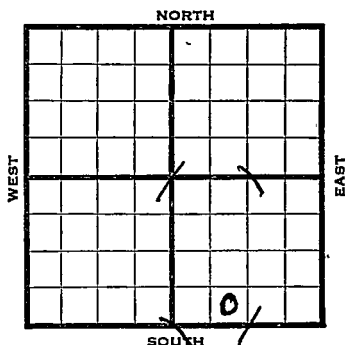

1938	REPORT
4/20	Location
4/29	C. R.
5/6	R. U.
5/12	15" @ 118'. Drlg. 180'.
5/20	Anhy 555'. 12" @ 565'.
	Drlg. 960'.
5/27	Drlg. 1840'.
6/3	10" @ 2000'. U. R. 2130'.
6/10	10" @ 2125'. U. R. 2243'.
6/17	10" at 2227'. --Est. 1 M' gas 2333 to 2335'. Topoka 2595'.
	T.D. 2690'. Fishing.
6/24	8" @ 2696'. Drlg. 2895'.
7/1	Topeka 2685' S.O. 2920-30
	7" 2957' S.O. 3068'
	Lans. 3085' S.O. & G 3232-37
	700' fluid 1 1/2 hrs. U.R. 7"
7/8	T. D. 3237'. 7" - 3226'. WOO.
	OVER

1938

- 7/15 Drilled plug. 100' oil 2 hrs.
Swab 29 oil in 3 hrs.
Filled 2900' oil in 8 hrs.
No wtr. Deepened to 3249'.
No increase. G. O.
- 7/22 4000 acid. Pump 10 oil per hr.
for 20 hrs. Will deepen.
- 7/29 5" - 3326'. Arb. 3346'.
S. S. O. 3350'. T.D. 3358'.
1 bailer oil per hour.
- 8/5 T.D. 3374'. 1100' oil in 12 hrs.
5" - 3348'. WOC.
- 8/12 2000 acid. Pumping 7 oil per hr.
- 8/19 4000 acid.
- 8/26 Testing.
- 8/31 7" - 3226'.
5" liner 3248'.
Arb. 3346'.
T. D. 3374'.
6000 acid.
Potential 502 oil & 45 water.

COMPLETED

Map No. 46 Sec. 36 Twp. 19 R. 12WWell No. 1 WolfCrown Petroleum

Company

Contractor


FIRST REPORT

SE SW SE

Ft. from N. Line

330 Ft. from S. Line

Ft. from E. Line

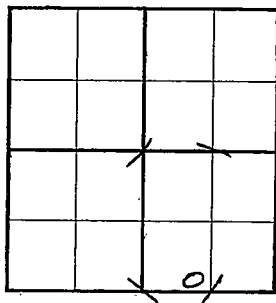990 Ft. from W. Line**SECTION PLAT**Location X

Rig up

Drilling and Remarks:

RECORD

Cased _____ in., _____ ft.

Sand _____

Gas _____

Oil _____

Total Depth _____

PRODUCTION

1st 24 hrs. Nat. _____

1st 24 hrs. after shot _____

Gas _____ Cu. Ft.

Dry Hole _____

Abandoned _____

Date

APR 20 1938

19

H. D. Hatfield

Scout

Barton **KANSAS**Map No. 46 Sec. 36 Twp. 19 R. 12WWell No. 1 Wolf**Crown Petroleum**

Company

Contractor

COMPLETED**SECTION PLAT****SE SW SE**

_____ Ft. from N. Line

330 Ft. from S. Line

_____ Ft. from E. Line

990 Ft. from W. Line

			0

Location _____

Rig up _____

Drilling and Remarks:

*6000 acid**POT 502 oil
45 wtr*

711- 3226
5' Line **RECORD** 3348
Cased _____ in., _____ ft.

Sand *Arb* 3346

Gas _____

Oil _____

Total Depth 3374**PRODUCTION**

1st 24 hrs. Nat: _____

1st 24 hrs. after shot _____

Gas _____ Cu. Ft.

Dry Hole _____

Abandoned _____

Date

AUG 31 1938 19**E. D. Hatfield**

Scout