


SECTION 36 TOWNSHIP 19S RANGE 12W

WELL NO. #1 Wolf "C"

COMPANY Francis Oil & Gas

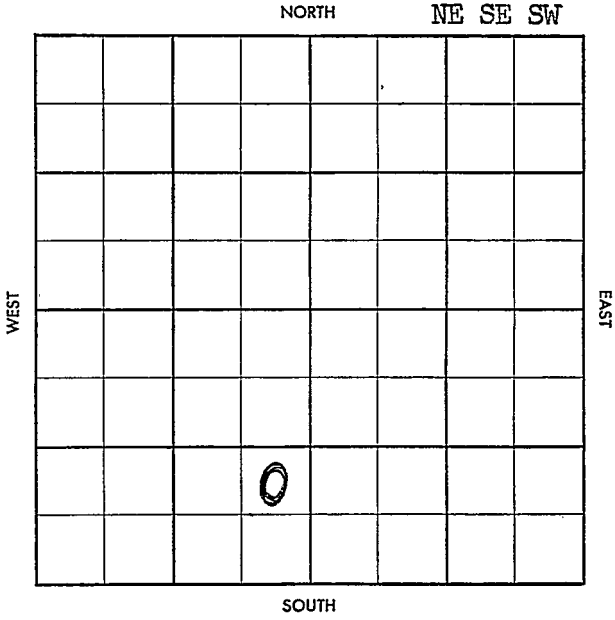

S-513-B

13

County Barton Elev. _____

Sec. 36 Twp. 19 Rge. 12W

Company Francis Oil & Gas

Farm Name Wolf "C" No. 1

TOPS	DEPTH	LOG	DATUM
Anh.			
Tp.			
H.			
Tr.			
Dg.			
B.L.			
L.			
K.C.			
B.K.C.			
Ce.			
C.			
M.			
M.			
K.			
Mz.			
Mq.			
V.			
S.			
S.			
A.			
R.			
Pf.			
G.			
T.D.			

Loc. in Sec. _____

NE SE SW

Geol. _____

Contr. _____

Veeder Tools

Pool _____

Hammer

FEB 12 58
FIRST REPORT

Date Comm. 2/7/58

8" @ 230 w/150, WOC

Co.

Lse.

No.

Sec.

T.

R.

S-513-B

County Barton Elev. 1798 OF 1801 RB
 Sec. 36 Twp. 19 Rge. 12W
 Company Francis Oil & Gas
 Farm Name Wolf "C" No. 1

TOPS	DEPTH	LOG	DATUM	Loc. in Sec.
Anh.				NE SE SW
Ip.				
H.	<u>2945</u>			
Tr.				
Dg.				
B.L.				
L.	<u>3083</u>			
K.C.				Geol.
B.K.C.				Contr.
Ce.				<u>Veeder Tools</u>
C.	<u>3328</u>			Pool
M.				<u>Hammer</u>
M.				
K.				
Mz.				
Mq.				
V.				
S.				
S.				
A.	<u>3336</u>			
R.				
Pf.				
G.				
T.D.	<u>3370</u>			

FEB 19 '58

ABANDONED

Date Comm. 2/7/58

8" @ 230 w/150, WOC FEB 19 '58 DST 3096
 - 3140 12" 2/4" BHP 1100
 DST 3143 - 76 60" 127'
 50 to 90m BHP 430 DST
 3226-3300 60" 1200' gip 215'
 U 50 to 90m 2' W FP 140-16. BHP
 870# 520 DST 3337-42 30" 8M
 BHP DST 3342-52-45" nec M
 BHP 960 DST 3352-70 60" 960'
 OC SW BHP O DST (6P) 3354-63

40' 17' N 84° P 860 no log

DBA

36-19-12W

no log