


Section 36 Township 19 Range 12 W

Well No. # 4 Birzer

Company W. L. Hartman

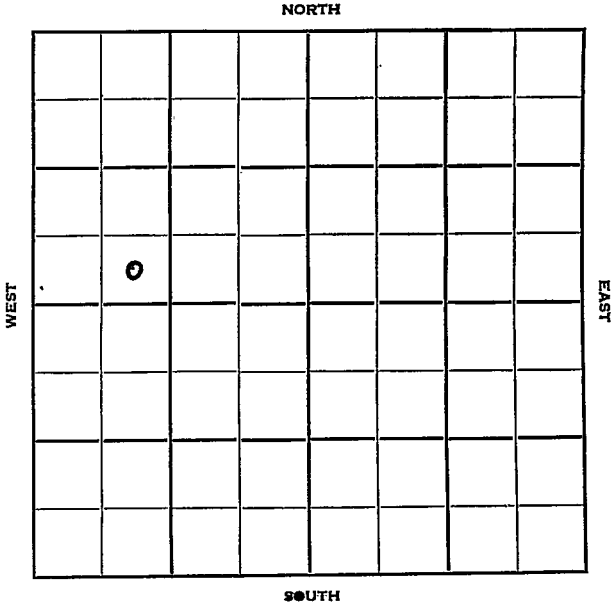

Sec. 36 Twp. 19 R. 12W

Well No. #4 Birzer Farm

W. L. Hartman Company

Contractor


 Ft. from N. Line

330 Ft. from S. Line

 Ft. from E. Line

990 Ft. from W. Line

SE SW NW

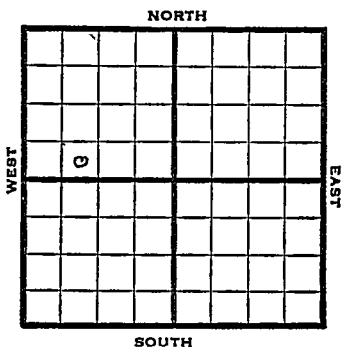

1952

Elev. 1798'

REPORT

8/13

Location

8/20

8" @ 135
Drlg. 2650'

8/27

Topeka 2703 Heeb. 2943
Br Li 3062 Lans. 3079
Drlg. 3275'

9/4

Oil Well TD 3358' 8" @ 135
Top. 2703 Heeb. 2943
Br Li 3062 Lans. 3079
Cong. 3328 Arb. 3348
TD 3358 5" @ 3357
Comp. 25 bopd

COMPLETED

