


KANSAS Barton

FORM 51 IOM 12-46 PETROL

Section 36 Township 19 Range 12W

Well No. 2 Wolfe "A"

Company C. E. Ash

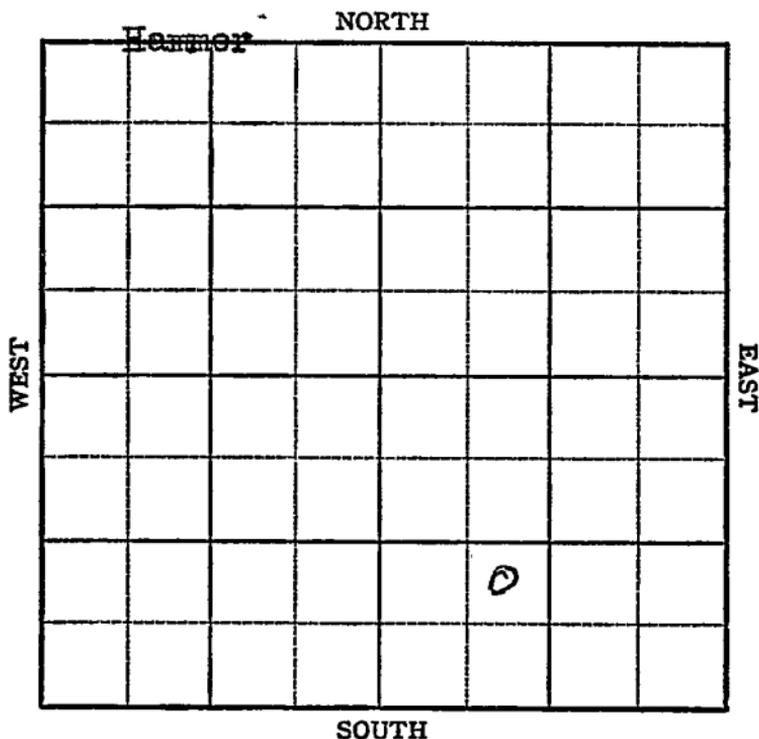

Sec. _____ Twp. _____ R. _____

Well No. #2 Wolfe "A" _____ Farm

C.E. Ash _____ Company

Hammer

_____ Ft. from N. Line

990


_____ Ft. from S. Line

_____ Ft. from E. Line

990

_____ Ft. from W. Line

NE SW SE

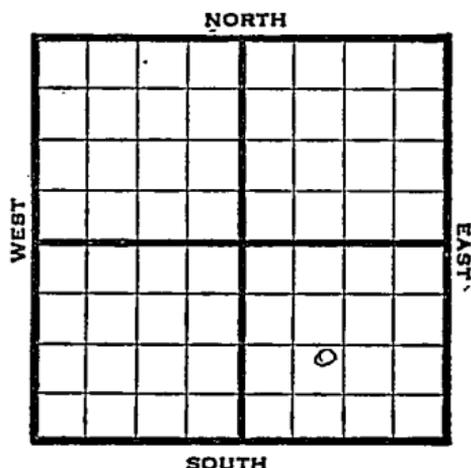

1947 Elev. 1793' REPORT

9/10	8" @ 327 Drlg 375
9/17	Drlg. 2963'
9/24	Lansing 3089' Arbuckle 3352' 3360' TD 5" @ 3357' RUST
10/1	"
10/8	"
10/15	"
10/22	"
10/29	TD 3372' Swb 2 oil in 8 hrs.
11/5	4000 Acid CO
11/12	"
11/19	"
11/25	"
12/3	Arb. 3352' 5" @ 3357' Total Depth 3375'

ABANDONED

Map No. _____ Sec. 36 Twp. 19 R. 12W

Well No. 2 Wolfe "A"

C. E. Ash _____ Company

FIRST REPORT _____ Contractor

NE SW SE


SECTION PLAT

_____ Ft. from N. Line

990 _____ Ft. from S. Line

_____ Ft. from E. Line

990 _____ Ft. from W. Line

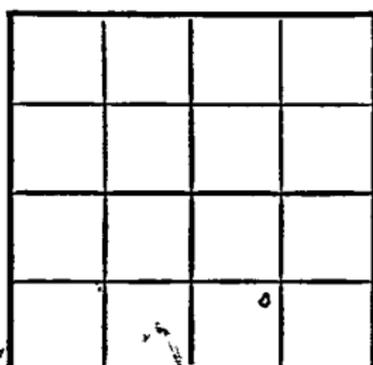

Barton County

RECORD

Location _____

Cased _____ in, _____ ft.

Rig up _____

Sand _____

Drilling and Remarks:

Gas _____

Oil _____

8" @ 327

Total Depth _____

drlg. 375

PRODUCTION

1st 24 hrs. Nat. _____

1st 24 hrs. after shot _____

Gas _____ Cu. Ft.

Dry Hole _____

Abandoned _____

Date

SEP 10 1947 19

S. J. LEWIS

Scout

